

09 00 00 FINISHES CONTINUED		09 00 00 FINISHES CONTINUED		06 00 00 WOOD, PLASTICS AND COMPOSITES CONT.		01 00 00 GENERAL REQUIREMENTS CONTINUED		01 00 00 GENERAL REQUIREMENTS CONTINUED		01 00 00 GENERAL REQUIREMENTS	
09 60 00 - FLOORING		09 60 00 - FLOORING		01 70 00 - EXECUTION AND CLOSEOUT REQUIREMENTS		01 70 00 - EXECUTION AND CLOSEOUT REQUIREMENTS		01 70 00 - EXECUTION AND CLOSEOUT REQUIREMENTS		01 70 00 - EXECUTION AND CLOSEOUT REQUIREMENTS	
1 CONTRACTOR SHALL FURNISH AND INSTALL ALL FLOOR FINISHES AS SPECIFIED ON THE DRAWINGS AND SPECIFICATIONS.		1 CONTRACTOR SHALL FURNISH AND INSTALL ALL FLOOR FINISHES AS SPECIFIED ON THE DRAWINGS AND SPECIFICATIONS.		1 THE CONTRACTOR SHALL BE FULLY AND SOLELY RESPONSIBLE FOR THE REMOVAL, REPLACEMENT AND RECTIFICATION OF ALL DAMAGED AND DEFECTIVE MATERIAL AND WORKMANSHIP IN CONNECTION WITH THE CONTRACT WORK. HE SHALL REPAIR OR REPAIR AS DIRECTED ALL SUCH DAMAGED OR DEFECTIVE MATERIALS WHICH SHALL APPEAR WITHIN A PERIOD OF ONE YEAR FROM THE DATE OF SUBSTANTIAL COMPLETION.		1 THE GENERAL CONTRACTOR SHALL PROVIDE SUBMITTALS FOR REVIEW AND APPROVAL BY SAA. CONTRACTOR SHALL SUBMIT THREE (3) SAMPLES OF THE SPECIFIED MATERIALS. SUBMITTALS SHALL INCLUDE BUT NOT BE LIMITED TO THE FOLLOWING: 1) 12" THICK-OUT SAMPLES OF ALL FLOOR FINISHES, SAMPLES OF ALL CARPETS, ALL SPECIFIED FLOOR AND BASE MATERIALS, SAMPLES OF ALL WALL FINISHES, SAMPLES OF SPECIFIED CABINET FINISHES, SAMPLES OF CEILING GRID AND CEILING TILE, CUTSHEETS OF LIGHTING FIXTURES, DOORFRAME AND BUILDERS HARDWARE, CASEWORK SHOP DRAWINGS, CASEWORK HARDWARE SUBMITTALS, AND ANY OTHER MATERIALS SPECIFIED.		1 THE GENERAL CONTRACTOR SHALL SUBMIT ALL FABRICATION SHOP DRAWINGS AND EQUIPMENT/FIXTURE CUTSHEETS TO SAA FOR REVIEW. CONTRACTOR SHALL PROVIDE THREE (3) COPIES. SAA SHALL HAVE TEN (10) WORK DAYS FROM SHOP DRAWING REVIEW TURNAROUND TIME FROM DATE OF RECEIPT. ALL SHOP DRAWINGS AND CUTSHEETS MARKED "REVIEW ONLY" SHALL BE RETURNED TO THE CONTRACTOR WITHIN TEN (10) WORK DAYS FROM DATE OF RECEIPT. CONTRACTOR SHALL ASSUME RESPONSIBILITY FOR ERRORS IN THEIR DRAWINGS.		1 THE OWNER WITHOUT INVALIDATING THE CONTRACT MAY ORDER EXTRA WORK OR MAKE CHANGES BY ALTERING, ADDING TO OR DEDUCTING FROM THE WORK. THE CONTRACT SUM SHALL BE ADJUSTED ACCORDINGLY. ALL SUCH WORK SHALL BE EXECUTED UNDER THE CONDITIONS OF THE ORIGINAL CONTRACT EXCEPT THAT ANY CLAIM FOR EXTENSION OF TIME CAUSED THEREBY SHALL BE ADJUSTED AT THE TIME OF ORDERING SUCH CHANGE.	
2 THE GENERAL CONTRACTOR SHALL NOTIFY SAA AFTER FLOOR PATCHING IS COMPLETE AND RECEIVE THEIR REVIEW AND ACCEPTANCE PRIOR TO INSTALLATION OF FINISHED FLOORING.		2 THE GENERAL CONTRACTOR SHALL PROVIDE SUFFICIENT FRAMING FOR ALL WALL PARTITIONS, AND FOR ALL DUCT WORK, RETURN AIR OPENINGS AND GRILL OPENINGS ABOVE AND BELOW HUNG CEILING. THESE OPENINGS ARE TO BE COORDINATED WITH HVAC ENGINEERING DRAWINGS AND THE MECHANICAL CONTRACTORS SHOP DRAWINGS. ALL OPENINGS SHALL BE PROPERLY SEALED FOR SOUNDPROOFING AND VIBRATION.		2 CONTRACTOR SHALL SUPPLY AND INSTALL ALL NECESSARY HARDWARE REQUIRED BY THE SPECIFICATIONS OR INTENT OF THE SPECIFICATIONS. SUBMIT TO SAA FOR APPROVAL CUT SHEETS OF ALL CABINET HARDWARE AND SAMPLES OF ALL PULLS AND KNOBS PRIOR TO FABRICATION.		2 THE GENERAL CONTRACTOR SHALL SUBMIT THE FOLLOWING: 1) 12" THICK-OUT SAMPLES OF ALL FLOOR FINISHES, SAMPLES OF ALL CARPETS, ALL SPECIFIED FLOOR AND BASE MATERIALS, SAMPLES OF ALL WALL FINISHES, SAMPLES OF SPECIFIED CABINET FINISHES, SAMPLES OF CEILING GRID AND CEILING TILE, CUTSHEETS OF LIGHTING FIXTURES, DOORFRAME AND BUILDERS HARDWARE, CASEWORK SHOP DRAWINGS, CASEWORK HARDWARE SUBMITTALS, AND ANY OTHER MATERIALS SPECIFIED.		2 THE GENERAL CONTRACTOR SHALL SUBMIT ALL FABRICATION SHOP DRAWINGS AND EQUIPMENT/FIXTURE CUTSHEETS TO SAA FOR REVIEW. CONTRACTOR SHALL PROVIDE THREE (3) COPIES. SAA SHALL HAVE TEN (10) WORK DAYS FROM SHOP DRAWING REVIEW TURNAROUND TIME FROM DATE OF RECEIPT. ALL SHOP DRAWINGS AND CUTSHEETS MARKED "REVIEW ONLY" SHALL BE RETURNED TO THE CONTRACTOR WITHIN TEN (10) WORK DAYS FROM DATE OF RECEIPT. CONTRACTOR SHALL ASSUME RESPONSIBILITY FOR ERRORS IN THEIR DRAWINGS.		2 THE GENERAL CONTRACTOR SHALL SUBMIT ALL FABRICATION SHOP DRAWINGS AND EQUIPMENT/FIXTURE CUTSHEETS TO SAA FOR REVIEW. CONTRACTOR SHALL PROVIDE THREE (3) COPIES. SAA SHALL HAVE TEN (10) WORK DAYS FROM SHOP DRAWING REVIEW TURNAROUND TIME FROM DATE OF RECEIPT. ALL SHOP DRAWINGS AND CUTSHEETS MARKED "REVIEW ONLY" SHALL BE RETURNED TO THE CONTRACTOR WITHIN TEN (10) WORK DAYS FROM DATE OF RECEIPT. CONTRACTOR SHALL ASSUME RESPONSIBILITY FOR ERRORS IN THEIR DRAWINGS.	
3 THE GENERAL CONTRACTOR SHALL NOTIFY SAA AFTER FLOOR PATCHING IS COMPLETE AND RECEIVE THEIR REVIEW AND ACCEPTANCE PRIOR TO INSTALLATION OF FINISHED FLOORING.		3 THE GENERAL CONTRACTOR SHALL PROVIDE AND INSTALL ALL ACCESS PANELS AS REQUIRED FOR MECHANICAL, ELECTRICAL AND PLUMBING INSTALLATIONS PER LOCAL BUILDING CODES. LOCATIONS SHALL BE COORDINATED WITH SAA PRIOR TO FINAL INSTALLATION.		3 CONTRACTOR TO PROTECT CASEWORK DURING DELIVERY AND TAKE NECESSARY PRECAUTIONS TO ENSURE THAT INSTALLATION OF CASEWORK AND FINISH CARPENTRY WILL NOT BE DAMAGED BY OTHER CONSTRUCTION WORK.		3 THE GENERAL CONTRACTOR SHALL SUBMIT THE FOLLOWING: 1) 12" THICK-OUT SAMPLES OF ALL FLOOR FINISHES, SAMPLES OF ALL CARPETS, ALL SPECIFIED FLOOR AND BASE MATERIALS, SAMPLES OF ALL WALL FINISHES, SAMPLES OF SPECIFIED CABINET FINISHES, SAMPLES OF CEILING GRID AND CEILING TILE, CUTSHEETS OF LIGHTING FIXTURES, DOORFRAME AND BUILDERS HARDWARE, CASEWORK SHOP DRAWINGS, CASEWORK HARDWARE SUBMITTALS, AND ANY OTHER MATERIALS SPECIFIED.		3 THE GENERAL CONTRACTOR SHALL SUBMIT ALL FABRICATION SHOP DRAWINGS AND EQUIPMENT/FIXTURE CUTSHEETS TO SAA FOR REVIEW. CONTRACTOR SHALL PROVIDE THREE (3) COPIES. SAA SHALL HAVE TEN (10) WORK DAYS FROM SHOP DRAWING REVIEW TURNAROUND TIME FROM DATE OF RECEIPT. ALL SHOP DRAWINGS AND CUTSHEETS MARKED "REVIEW ONLY" SHALL BE RETURNED TO THE CONTRACTOR WITHIN TEN (10) WORK DAYS FROM DATE OF RECEIPT. CONTRACTOR SHALL ASSUME RESPONSIBILITY FOR ERRORS IN THEIR DRAWINGS.		3 THE GENERAL CONTRACTOR SHALL SUBMIT ALL FABRICATION SHOP DRAWINGS AND EQUIPMENT/FIXTURE CUTSHEETS TO SAA FOR REVIEW. CONTRACTOR SHALL PROVIDE THREE (3) COPIES. SAA SHALL HAVE TEN (10) WORK DAYS FROM SHOP DRAWING REVIEW TURNAROUND TIME FROM DATE OF RECEIPT. ALL SHOP DRAWINGS AND CUTSHEETS MARKED "REVIEW ONLY" SHALL BE RETURNED TO THE CONTRACTOR WITHIN TEN (10) WORK DAYS FROM DATE OF RECEIPT. CONTRACTOR SHALL ASSUME RESPONSIBILITY FOR ERRORS IN THEIR DRAWINGS.	
4 SPACES BEING SURFACED SHALL BE CLOSED TO TRAFFIC AND OTHER WORK DURING THE LAYING OF FLOORING. STONE FLOORS SHALL BE COVERED AFTER INSTALLATION FOR PROTECTION.		4 SPACES BEING SURFACED SHALL BE CLOSED TO TRAFFIC AND OTHER WORK DURING THE LAYING OF FLOORING. STONE FLOORS SHALL BE COVERED AFTER INSTALLATION FOR PROTECTION.		4 COMPOSITE WOOD AND AGGRIFER PRODUCTS, INCLUDING CORE MATERIALS, SHALL NOT CONTAIN ANY UREA-FORMALDEHYDE RESINS.		4 WHERE THE TERMS "PROVIDE" OR "PROVIDED" IN CONNECTION WITH ANY ITEM SPECIFIED IS INTERPRETED TO MEAN, UNLESS OTHERWISE NOTED, THAT WHICH SHALL BE FURNISHED AND INSTALLED, AND CONNECTED WHERE SO REQUIRED.		4 THE GENERAL CONTRACTOR SHALL SUBMIT ALL FABRICATION SHOP DRAWINGS AND EQUIPMENT/FIXTURE CUTSHEETS TO SAA FOR REVIEW. CONTRACTOR SHALL PROVIDE THREE (3) COPIES. SAA SHALL HAVE TEN (10) WORK DAYS FROM SHOP DRAWING REVIEW TURNAROUND TIME FROM DATE OF RECEIPT. ALL SHOP DRAWINGS AND CUTSHEETS MARKED "REVIEW ONLY" SHALL BE RETURNED TO THE CONTRACTOR WITHIN TEN (10) WORK DAYS FROM DATE OF RECEIPT. CONTRACTOR SHALL ASSUME RESPONSIBILITY FOR ERRORS IN THEIR DRAWINGS.		4 THE GENERAL CONTRACTOR SHALL SUBMIT ALL FABRICATION SHOP DRAWINGS AND EQUIPMENT/FIXTURE CUTSHEETS TO SAA FOR REVIEW. CONTRACTOR SHALL PROVIDE THREE (3) COPIES. SAA SHALL HAVE TEN (10) WORK DAYS FROM SHOP DRAWING REVIEW TURNAROUND TIME FROM DATE OF RECEIPT. ALL SHOP DRAWINGS AND CUTSHEETS MARKED "REVIEW ONLY" SHALL BE RETURNED TO THE CONTRACTOR WITHIN TEN (10) WORK DAYS FROM DATE OF RECEIPT. CONTRACTOR SHALL ASSUME RESPONSIBILITY FOR ERRORS IN THEIR DRAWINGS.	
5 UPON COMPLETION, ALL WORK SHALL BE CLEANED BY THE CONTRACTOR REMOVING ALL SPOTS OF ADHESIVE AND SURFACE STAINS AND ALL CARDS, CARTONS AND CONTAINERS SHALL BE REMOVED FROM THE BUILDING.		5 UPON COMPLETION, ALL WORK SHALL BE CLEANED BY THE CONTRACTOR REMOVING ALL SPOTS OF ADHESIVE AND SURFACE STAINS AND ALL CARDS, CARTONS AND CONTAINERS SHALL BE REMOVED FROM THE BUILDING.		5 LAMINATE ADHESIVES USED TO FABRICATE CASEWORK ON-SITE AND SHOP APPLIED ASSEMBLIES CONTAINING THESE LAMINATE ADHESIVES SHALL NOT CONTAIN ANY UREA-FORMALDEHYDE.		5 THE USE OF THE WORDS "PROVIDE" OR "PROVIDED" IN CONNECTION WITH ANY ITEM SPECIFIED IS INTERPRETED TO MEAN, UNLESS OTHERWISE NOTED, THAT WHICH SHALL BE FURNISHED AND INSTALLED, AND CONNECTED WHERE SO REQUIRED.		5 ALL SAA DRAWINGS AND ALL CONSTRUCTION NOTES ARE COMPLEMENTARY, AND WHAT IS CALLED FOR BY EITHER WALL OR FLOOR FINISHES SHALL BE PROVIDED AS SHOWN THROUGHOUT ALL RELATED DRAWINGS.		5 ALL SAA DRAWINGS AND ALL CONSTRUCTION NOTES ARE COMPLEMENTARY, AND WHAT IS CALLED FOR BY EITHER WALL OR FLOOR FINISHES SHALL BE PROVIDED AS SHOWN THROUGHOUT ALL RELATED DRAWINGS.	
6 STONE, WOOD, AND ALL FLOORING CONTRACTORS TO SUBMIT TO SAA ACTUAL DIMENSIONED LAYOUT PLAN FOR APPROVAL PRIOR TO INSTALLATION.		6 STONE, WOOD, AND ALL FLOORING CONTRACTORS TO SUBMIT TO SAA ACTUAL DIMENSIONED LAYOUT PLAN FOR APPROVAL PRIOR TO INSTALLATION.		6 ADHESIVES AND SEALANTS USED FOR WALLWORK, PANELING, OR VENEERING SHALL BE LOW VOC AND MUST NOT EXCEED THE VOC CONTENT LIMITS OF SCAQMD RULE #1168 REQUIREMENTS IN EFFECT ON JANUARY 1, 2011.		6 WHERE THE TERMS "NO EXCEPTION", "APPROVED ONLY", "OTHER APPROVED", "EQUAL TO", "ACCEPTABLE" OR ANY OTHER GENERAL QUALIFYING TERMS ARE USED IN THESE NOTES, IT SHALL BE UNDERSTOOD THAT REFERENCE IS MADE TO THE SOLE INTERPRETING AND JUDGMENT OF SAA.		6 INSURANCE AND BONDING FOR THE PROJECT SHALL BE AS DIRECTED BY AND TO THE SATISFACTION OF THE OWNER, AND AS REQUIRED IN THE OWNER-CONTRACTOR AGREEMENT.		6 INSURANCE AND BONDING FOR THE PROJECT SHALL BE AS DIRECTED BY AND TO THE SATISFACTION OF THE OWNER, AND AS REQUIRED IN THE OWNER-CONTRACTOR AGREEMENT.	
7 THE GENERAL CONTRACTOR SHALL COORDINATE ALL FLOORING CONTRACTORS INVOLVED TO ASSURE FLUSH INSTALLATION OF ALL VARYING FLOOR MATERIALS USED. THE INSTALLATION METHODS TO BE APPROVED BY SHELMEER-ALGAZE-ASSOCIATES.		7 THE GENERAL CONTRACTOR SHALL COORDINATE ALL FLOORING CONTRACTORS INVOLVED TO ASSURE FLUSH INSTALLATION OF ALL VARYING FLOOR MATERIALS USED. THE INSTALLATION METHODS TO BE APPROVED BY SHELMEER-ALGAZE-ASSOCIATES.		7 STANDARD DRYWALL STUDS SHALL BE ELECTRO-GALVANIZED STEEL WITH PUNCHED UTILITY OPENINGS AND KNURLED FLANGE WITH AT LEAST 1-1/4" WIDE FLANGE RETURNS. FINISH 25 GA. STUDS EXCEPT WHERE 20 GAUGE OR HEAVIER IS SHOWN OR REQUIRED ON THE DRAWINGS.		7 THE GENERAL CONTRACTOR SHALL SUBMIT ALL FABRICATION SHOP DRAWINGS AND EQUIPMENT/FIXTURE CUTSHEETS TO SAA FOR REVIEW. CONTRACTOR SHALL PROVIDE THREE (3) COPIES. SAA SHALL HAVE TEN (10) WORK DAYS FROM SHOP DRAWING REVIEW TURNAROUND TIME FROM DATE OF RECEIPT. ALL SHOP DRAWINGS AND CUTSHEETS MARKED "REVIEW ONLY" SHALL BE RETURNED TO THE CONTRACTOR WITHIN TEN (10) WORK DAYS FROM DATE OF RECEIPT. CONTRACTOR SHALL ASSUME RESPONSIBILITY FOR ERRORS IN THEIR DRAWINGS.		7 THE GENERAL CONTRACTOR SHALL SUBMIT ALL FABRICATION SHOP DRAWINGS AND EQUIPMENT/FIXTURE CUTSHEETS TO SAA FOR REVIEW. CONTRACTOR SHALL PROVIDE THREE (3) COPIES. SAA SHALL HAVE TEN (10) WORK DAYS FROM SHOP DRAWING REVIEW TURNAROUND TIME FROM DATE OF RECEIPT. ALL SHOP DRAWINGS AND CUTSHEETS MARKED "REVIEW ONLY" SHALL BE RETURNED TO THE CONTRACTOR WITHIN TEN (10) WORK DAYS FROM DATE OF RECEIPT. CONTRACTOR SHALL ASSUME RESPONSIBILITY FOR ERRORS IN THEIR DRAWINGS.		7 THE GENERAL CONTRACTOR SHALL SUBMIT ALL FABRICATION SHOP DRAWINGS AND EQUIPMENT/FIXTURE CUTSHEETS TO SAA FOR REVIEW. CONTRACTOR SHALL PROVIDE THREE (3) COPIES. SAA SHALL HAVE TEN (10) WORK DAYS FROM SHOP DRAWING REVIEW TURNAROUND TIME FROM DATE OF RECEIPT. ALL SHOP DRAWINGS AND CUTSHEETS MARKED "REVIEW ONLY" SHALL BE RETURNED TO THE CONTRACTOR WITHIN TEN (10) WORK DAYS FROM DATE OF RECEIPT. CONTRACTOR SHALL ASSUME RESPONSIBILITY FOR ERRORS IN THEIR DRAWINGS.	
8 CLOSET FLOORS ARE TO HAVE SAME FLOORING AS THE FLOORING IN ADJACENT AREA, UNLESS OTHERWISE NOTED.		8 CLOSET FLOORS ARE TO HAVE SAME FLOORING AS THE FLOORING IN ADJACENT AREA, UNLESS OTHERWISE NOTED.		8 GAUGE SPECIFIED ABOVE ARE A MINIMUM, WHERE REQUIRED STUD HEIGHT EXCEEDS CODE COMPLIANCE, PROVIDE HEAVIER GAUGE STUDS OR DECREASE STUD SPACING AS NECESSARY TO CONFORM TO CODE.		8 THE GENERAL CONTRACTOR SHALL SUBMIT ALL FABRICATION SHOP DRAWINGS AND EQUIPMENT/FIXTURE CUTSHEETS TO SAA FOR REVIEW. CONTRACTOR SHALL PROVIDE THREE (3) COPIES. SAA SHALL HAVE TEN (10) WORK DAYS FROM SHOP DRAWING REVIEW TURNAROUND TIME FROM DATE OF RECEIPT. ALL SHOP DRAWINGS AND CUTSHEETS MARKED "REVIEW ONLY" SHALL BE RETURNED TO THE CONTRACTOR WITHIN TEN (10) WORK DAYS FROM DATE OF RECEIPT. CONTRACTOR SHALL ASSUME RESPONSIBILITY FOR ERRORS IN THEIR DRAWINGS.		8 THE GENERAL CONTRACTOR SHALL SUBMIT ALL FABRICATION SHOP DRAWINGS AND EQUIPMENT/FIXTURE CUTSHEETS TO SAA FOR REVIEW. CONTRACTOR SHALL PROVIDE THREE (3) COPIES. SAA SHALL HAVE TEN (10) WORK DAYS FROM SHOP DRAWING REVIEW TURNAROUND TIME FROM DATE OF RECEIPT. ALL SHOP DRAWINGS AND CUTSHEETS MARKED "REVIEW ONLY" SHALL BE RETURNED TO THE CONTRACTOR WITHIN TEN (10) WORK DAYS FROM DATE OF RECEIPT. CONTRACTOR SHALL ASSUME RESPONSIBILITY FOR ERRORS IN THEIR DRAWINGS.		8 THE GENERAL CONTRACTOR SHALL SUBMIT ALL FABRICATION SHOP DRAWINGS AND EQUIPMENT/FIXTURE CUTSHEETS TO SAA FOR REVIEW. CONTRACTOR SHALL PROVIDE THREE (3) COPIES. SAA SHALL HAVE TEN (10) WORK DAYS FROM SHOP DRAWING REVIEW TURNAROUND TIME FROM DATE OF RECEIPT. ALL SHOP DRAWINGS AND CUTSHEETS MARKED "REVIEW ONLY" SHALL BE RETURNED TO THE CONTRACTOR WITHIN TEN (10) WORK DAYS FROM DATE OF RECEIPT. CONTRACTOR SHALL ASSUME RESPONSIBILITY FOR ERRORS IN THEIR DRAWINGS.	
9 THE GENERAL CONTRACTOR SHALL VERIFY AVAILABILITY OF ALL PRODUCTS SPECIFIED AND NOTIFY ARCHITECT IMMEDIATELY IF THERE ARE ANY DISCREPANCIES WITH PROJECT COMPLETION DATE. PRODUCTS MAY REQUIRE A TWO TO SIX WEEK LEAD-TIME. NOTIFY ARCHITECT OF ALL LONG LEAD ITEMS.		9 THE GENERAL CONTRACTOR SHALL VERIFY AVAILABILITY OF ALL PRODUCTS SPECIFIED AND NOTIFY ARCHITECT IMMEDIATELY IF THERE ARE ANY DISCREPANCIES WITH PROJECT COMPLETION DATE. PRODUCTS MAY REQUIRE A TWO TO SIX WEEK LEAD-TIME. NOTIFY ARCHITECT OF ALL LONG LEAD ITEMS.		9 ALL INTERIOR PARTITIONS HAVE BEEN DESIGNED COMPLY TO 2016 CBC 1907.5 AND CAN WITHSTAND A HORIZONTAL LOAD OF 5 LBS. SEE SHEET A-0.1.		9 THE GENERAL CONTRACTOR SHALL SUBMIT ALL FABRICATION SHOP DRAWINGS AND EQUIPMENT/FIXTURE CUTSHEETS TO SAA FOR REVIEW. CONTRACTOR SHALL PROVIDE THREE (3) COPIES. SAA SHALL HAVE TEN (10) WORK DAYS FROM SHOP DRAWING REVIEW TURNAROUND TIME FROM DATE OF RECEIPT. ALL SHOP DRAWINGS AND CUTSHEETS MARKED "REVIEW ONLY" SHALL BE RETURNED TO THE CONTRACTOR WITHIN TEN (10) WORK DAYS FROM DATE OF RECEIPT. CONTRACTOR SHALL ASSUME RESPONSIBILITY FOR ERRORS IN THEIR DRAWINGS.		9 THE GENERAL CONTRACTOR SHALL SUBMIT ALL FABRICATION SHOP DRAWINGS AND EQUIPMENT/FIXTURE CUTSHEETS TO SAA FOR REVIEW. CONTRACTOR SHALL PROVIDE THREE (3) COPIES. SAA SHALL HAVE TEN (10) WORK DAYS FROM SHOP DRAWING REVIEW TURNAROUND TIME FROM DATE OF RECEIPT. ALL SHOP DRAWINGS AND CUTSHEETS MARKED "REVIEW ONLY" SHALL BE RETURNED TO THE CONTRACTOR WITHIN TEN (10) WORK DAYS FROM DATE OF RECEIPT. CONTRACTOR SHALL ASSUME RESPONSIBILITY FOR ERRORS IN THEIR DRAWINGS.		9 THE GENERAL CONTRACTOR SHALL SUBMIT ALL FABRICATION SHOP DRAWINGS AND EQUIPMENT/FIXTURE CUTSHEETS TO SAA FOR REVIEW. CONTRACTOR SHALL PROVIDE THREE (3) COPIES. SAA SHALL HAVE TEN (10) WORK DAYS FROM SHOP DRAWING REVIEW TURNAROUND TIME FROM DATE OF RECEIPT. ALL SHOP DRAWINGS AND CUTSHEETS MARKED "REVIEW ONLY" SHALL BE RETURNED TO THE CONTRACTOR WITHIN TEN (10) WORK DAYS FROM DATE OF RECEIPT. CONTRACTOR SHALL ASSUME RESPONSIBILITY FOR ERRORS IN THEIR DRAWINGS.	
10 NO SUBSTITUTIONS OF ANY MATERIAL ALLOWED WITHOUT WRITTEN APPROVAL OF ARCHITECT.		10 NO SUBSTITUTIONS OF ANY MATERIAL ALLOWED WITHOUT WRITTEN APPROVAL OF ARCHITECT.		10 ALL GYPSUM BOARD CONSTRUCTION IS TO MEET THE GYPSUM ASSOCIATION STANDARDS AS ENFORCED BY THE SOUTHERN CALIFORNIA DRYWALL CONTRACTORS ASSOCIATION INC.		10 THE GENERAL CONTRACTOR SHALL SUBMIT ALL FABRICATION SHOP DRAWINGS AND EQUIPMENT/FIXTURE CUTSHEETS TO SAA FOR REVIEW. CONTRACTOR SHALL PROVIDE THREE (3) COPIES. SAA SHALL HAVE TEN (10) WORK DAYS FROM SHOP DRAWING REVIEW TURNAROUND TIME FROM DATE OF RECEIPT. ALL SHOP DRAWINGS AND CUTSHEETS MARKED "REVIEW ONLY" SHALL BE RETURNED TO THE CONTRACTOR WITHIN TEN (10) WORK DAYS FROM DATE OF RECEIPT. CONTRACTOR SHALL ASSUME RESPONSIBILITY FOR ERRORS IN THEIR DRAWINGS.		10 THE GENERAL CONTRACTOR SHALL SUBMIT ALL FABRICATION SHOP DRAWINGS AND EQUIPMENT/FIXTURE CUTSHEETS TO SAA FOR REVIEW. CONTRACTOR SHALL PROVIDE THREE (3) COPIES. SAA SHALL HAVE TEN (10) WORK DAYS FROM SHOP DRAWING REVIEW TURNAROUND TIME FROM DATE OF RECEIPT. ALL SHOP DRAWINGS AND CUTSHEETS MARKED "REVIEW ONLY" SHALL BE RETURNED TO THE CONTRACTOR WITHIN TEN (10) WORK DAYS FROM DATE OF RECEIPT. CONTRACTOR SHALL ASSUME RESPONSIBILITY FOR ERRORS IN THEIR DRAWINGS.		10 THE GENERAL CONTRACTOR SHALL SUBMIT ALL FABRICATION SHOP DRAWINGS AND EQUIPMENT/FIXTURE CUTSHEETS TO SAA FOR REVIEW. CONTRACTOR SHALL PROVIDE THREE (3) COPIES. SAA SHALL HAVE TEN (10) WORK DAYS FROM SHOP DRAWING REVIEW TURNAROUND TIME FROM DATE OF RECEIPT. ALL SHOP DRAWINGS AND CUTSHEETS MARKED "REVIEW ONLY" SHALL BE RETURNED TO THE CONTRACTOR WITHIN TEN (10) WORK DAYS FROM DATE OF RECEIPT. CONTRACTOR SHALL ASSUME RESPONSIBILITY FOR ERRORS IN THEIR DRAWINGS.	
11 PROVIDE APPROPRIATE SEALER FOR STONE FLOORING TO ACHIEVE THE "P" COEFFICIENT REQUIRED BY CODE. OBTAIN ALL TEST RESULTS AND PROVIDE THE ORIGINAL TEST RESULTS TO THE SAA. APPLY SEALER PER MANUFACTURERS INSTRUCTIONS.		11 PROVIDE APPROPRIATE SEALER FOR STONE FLOORING TO ACHIEVE THE "P" COEFFICIENT REQUIRED BY CODE. OBTAIN ALL TEST RESULTS AND PROVIDE THE ORIGINAL TEST RESULTS TO THE SAA. APPLY SEALER PER MANUFACTURERS INSTRUCTIONS.		11 THE GENERAL CONTRACTOR SHALL SUBMIT ALL FABRICATION SHOP DRAWINGS AND EQUIPMENT/FIXTURE CUTSHEETS TO SAA FOR REVIEW. CONTRACTOR SHALL PROVIDE THREE (3) COPIES. SAA SHALL HAVE TEN (10) WORK DAYS FROM SHOP DRAWING REVIEW TURNAROUND TIME FROM DATE OF RECEIPT. ALL SHOP DRAWINGS AND CUTSHEETS MARKED "REVIEW ONLY" SHALL BE RETURNED TO THE CONTRACTOR WITHIN TEN (10) WORK DAYS FROM DATE OF RECEIPT. CONTRACTOR SHALL ASSUME RESPONSIBILITY FOR ERRORS IN THEIR DRAWINGS.		11 THE GENERAL CONTRACTOR SHALL SUBMIT ALL FABRICATION SHOP DRAWINGS AND EQUIPMENT/FIXTURE CUTSHEETS TO SAA FOR REVIEW. CONTRACTOR SHALL PROVIDE THREE (3) COPIES. SAA SHALL HAVE TEN (10) WORK DAYS FROM SHOP DRAWING REVIEW TURNAROUND TIME FROM DATE OF RECEIPT. ALL SHOP DRAWINGS AND CUTSHEETS MARKED "REVIEW ONLY" SHALL BE RETURNED TO THE CONTRACTOR WITHIN TEN (10) WORK DAYS FROM DATE OF RECEIPT. CONTRACTOR SHALL ASSUME RESPONSIBILITY FOR ERRORS IN THEIR DRAWINGS.		11 THE GENERAL CONTRACTOR SHALL SUBMIT ALL FABRICATION SHOP DRAWINGS AND EQUIPMENT/FIXTURE CUTSHEETS TO SAA FOR REVIEW. CONTRACTOR SHALL PROVIDE THREE (3) COPIES. SAA SHALL HAVE TEN (10) WORK DAYS FROM SHOP DRAWING REVIEW TURNAROUND TIME FROM DATE OF RECEIPT. ALL SHOP DRAWINGS AND CUTSHEETS MARKED "REVIEW ONLY" SHALL BE RETURNED TO THE CONTRACTOR WITHIN TEN (10) WORK DAYS FROM DATE OF RECEIPT. CONTRACTOR SHALL ASSUME RESPONSIBILITY FOR ERRORS IN THEIR DRAWINGS.		11 THE GENERAL CONTRACTOR SHALL SUBMIT ALL FABRICATION SHOP DRAWINGS AND EQUIPMENT/FIXTURE CUTSHEETS TO SAA FOR REVIEW. CONTRACTOR SHALL PROVIDE THREE (3) COPIES. SAA SHALL HAVE TEN (10) WORK DAYS FROM SHOP DRAWING REVIEW TURNAROUND TIME FROM DATE OF RECEIPT. ALL SHOP DRAWINGS AND CUTSHEETS MARKED "REVIEW ONLY" SHALL BE RETURNED TO THE CONTRACTOR WITHIN TEN (10) WORK DAYS FROM DATE OF RECEIPT. CONTRACTOR SHALL ASSUME RESPONSIBILITY FOR ERRORS IN THEIR DRAWINGS.	
12 THE GENERAL CONTRACTOR SHALL PROVIDE AND MAINTAIN ADEQUATE PROTECTION FOR ALL RESIDENT FLOORING WORK FOR THE DURATION OF THE CONTRACT, AND REMOVE ALL PROTECTION PRIOR TO PUNCH LIST.		12 THE GENERAL CONTRACTOR SHALL PROVIDE AND MAINTAIN ADEQUATE PROTECTION FOR ALL RESIDENT FLOORING WORK FOR THE DURATION OF THE CONTRACT, AND REMOVE ALL PROTECTION PRIOR TO PUNCH LIST.		12 THE GENERAL CONTRACTOR SHALL SUBMIT ALL FABRICATION SHOP DRAWINGS AND EQUIPMENT/FIXTURE CUTSHEETS TO SAA FOR REVIEW. CONTRACTOR SHALL PROVIDE THREE (3) COPIES. SAA SHALL HAVE TEN (10) WORK DAYS FROM SHOP DRAWING REVIEW TURNAROUND TIME FROM DATE OF RECEIPT. ALL SHOP DRAWINGS AND CUTSHEETS MARKED "REVIEW ONLY" SHALL BE RETURNED TO THE CONTRACTOR WITHIN TEN (10) WORK DAYS FROM DATE OF RECEIPT. CONTRACTOR SHALL ASSUME RESPONSIBILITY FOR ERRORS IN THEIR DRAWINGS.		12 THE GENERAL CONTRACTOR SHALL SUBMIT ALL FABRICATION SHOP DRAWINGS AND EQUIPMENT/FIXTURE CUTSHEETS TO SAA FOR REVIEW. CONTRACTOR SHALL PROVIDE THREE (3) COPIES. SAA SHALL HAVE TEN (10) WORK DAYS FROM SHOP DRAWING REVIEW TURNAROUND TIME FROM DATE OF RECEIPT. ALL SHOP DRAWINGS AND CUTSHEETS MARKED "REVIEW ONLY" SHALL BE RETURNED TO THE CONTRACTOR WITHIN TEN (10) WORK DAYS FROM DATE OF RECEIPT. CONTRACTOR SHALL ASSUME RESPONSIBILITY FOR ERRORS IN THEIR DRAWINGS.		12 THE GENERAL CONTRACTOR SHALL SUBMIT ALL FABRICATION SHOP DRAWINGS AND EQUIPMENT/FIXTURE CUTSHEETS TO SAA FOR REVIEW. CONTRACTOR SHALL PROVIDE THREE (3) COPIES. SAA SHALL HAVE TEN (10) WORK DAYS FROM SHOP DRAWING REVIEW TURNAROUND TIME FROM DATE OF RECEIPT. ALL SHOP DRAWINGS AND CUTSHEETS MARKED "REVIEW ONLY" SHALL BE RETURNED TO THE CONTRACTOR WITHIN TEN (10) WORK DAYS FROM DATE OF RECEIPT. CONTRACTOR SHALL ASSUME RESPONSIBILITY FOR ERRORS IN THEIR DRAWINGS.		12 THE GENERAL CONTRACTOR SHALL SUBMIT ALL FABRICATION SHOP DRAWINGS AND EQUIPMENT/FIXTURE CUTSHEETS TO SAA FOR REVIEW. CONTRACTOR SHALL PROVIDE THREE (3) COPIES. SAA SHALL HAVE TEN (10) WORK DAYS FROM SHOP DRAWING REVIEW TURNAROUND TIME FROM DATE OF RECEIPT. ALL SHOP DRAWINGS AND CUTSHEETS MARKED "REVIEW ONLY" SHALL BE RETURNED TO THE CONTRACTOR WITHIN TEN (10) WORK DAYS FROM DATE OF RECEIPT. CONTRACTOR SHALL ASSUME RESPONSIBILITY FOR ERRORS IN THEIR DRAWINGS.	
09 65 00 - RESILIENT FLOORING		09 65 00 - RESILIENT FLOORING		13 ALL CASEWORK SHOWN SHALL HAVE PLASTIC LAMINATE TOPS, UNLESS OTHERWISE NOTED.		13 THE GENERAL CONTRACTOR SHALL SUBMIT ALL FABRICATION SHOP DRAWINGS AND EQUIPMENT/FIXTURE CUTSHEETS TO SAA FOR REVIEW. CONTRACTOR SHALL PROVIDE THREE (3) COPIES. SAA SHALL HAVE TEN (10) WORK DAYS FROM SHOP DRAWING REVIEW TURNAROUND TIME FROM DATE OF RECEIPT. ALL SHOP DRAWINGS AND CUTSHEETS MARKED "REVIEW ONLY" SHALL BE RETURNED TO THE CONTRACTOR WITHIN TEN (10) WORK DAYS FROM DATE OF RECEIPT. CONTRACTOR SHALL ASSUME RESPONSIBILITY FOR ERRORS IN THEIR DRAWINGS.		13 THE GENERAL CONTRACTOR SHALL SUBMIT ALL FABRICATION SHOP DRAWINGS AND EQUIPMENT/FIXTURE CUTSHEETS TO SAA FOR REVIEW. CONTRACTOR SHALL PROVIDE THREE (3) COPIES. SAA SHALL HAVE TEN (10) WORK DAYS FROM SHOP DRAWING REVIEW TURNAROUND TIME FROM DATE OF RECEIPT. ALL SHOP DRAWINGS AND CUTSHEETS MARKED "REVIEW ONLY" SHALL BE RETURNED TO THE CONTRACTOR WITHIN TEN (10) WORK DAYS FROM DATE OF RECEIPT. CONTRACTOR SHALL ASSUME RESPONSIBILITY FOR ERRORS IN THEIR DRAWINGS.		13 THE GENERAL CONTRACTOR SHALL SUBMIT ALL FABRICATION SHOP DRAWINGS AND EQUIPMENT/FIXTURE CUTSHEETS TO SAA FOR REVIEW. CONTRACTOR SHALL PROVIDE THREE (3) COPIES. SAA SHALL HAVE TEN (10) WORK DAYS FROM SHOP DRAWING REVIEW TURNAROUND TIME FROM DATE OF RECEIPT. ALL SHOP DRAWINGS AND CUTSHEETS MARKED "REVIEW ONLY" SHALL BE RETURNED TO THE CONTRACTOR WITHIN TEN (10) WORK DAYS FROM DATE OF RECEIPT. CONTRACTOR SHALL ASSUME RESPONSIBILITY FOR ERRORS IN THEIR DRAWINGS.	
1 THE GENERAL CONTRACTOR, AFTER PROPERLY CLEANING THE FLOORING MATERIAL, SHALL GIVE RESILIENT TILE FLOOR TWO (2) APPLICATIONS OF AN APPROVED NON-SLIP WAX WHICH IS TO BE THOROUGHLY MACHINE BUFFED AND LEFT IN CONDITION ENTIRELY SATISFACTORY TO SHELMEER-ALGAZE-ASSOCIATES.		1 RUBBER AND/OR VINYL BASE SHALL, IN ALL CONDITIONS MATCH THE COLOR OF ADJACENT WALL U.O.N. GENERAL CONTRACTOR TO CONFIRM WITH SAA EXACT COLOR IF NOT SPECIFIED ON DRAWINGS AND SUBMIT SAMPLE OF COLORED BASE TO SAA FOR APPROVAL PRIOR TO PURCHASE AND INSTALLATION.		14 ALL GYPSUM BOARD CONSTRUCTION IS TO MEET THE GYPSUM ASSOCIATION STANDARDS AS ENFORCED BY THE SOUTHERN CALIFORNIA DRYWALL CONTRACTORS ASSOCIATION INC.		14 THE GENERAL CONTRACTOR SHALL SUBMIT ALL FABRICATION SHOP DRAWINGS AND EQUIPMENT/FIXTURE CUTSHEETS TO SAA FOR REVIEW. CONTRACTOR SHALL PROVIDE THREE (3) COPIES. SAA SHALL HAVE TEN (10) WORK DAYS FROM SHOP DRAWING REVIEW TURNAROUND TIME FROM DATE OF RECEIPT. ALL SHOP DRAWINGS AND CUTSHEETS MARKED "REVIEW ONLY" SHALL BE RETURNED TO THE CONTRACTOR WITHIN TEN (10) WORK DAYS FROM DATE OF RECEIPT. CONTRACTOR SHALL ASSUME RESPONSIBILITY FOR ERRORS IN THEIR DRAWINGS.		14 THE GENERAL CONTRACTOR SHALL SUBMIT ALL FABRICATION SHOP DRAWINGS AND EQUIPMENT/FIXTURE CUTSHEETS TO SAA FOR REVIEW. CONTRACTOR SHALL PROVIDE THREE (3) COPIES. SAA SHALL HAVE TEN (10) WORK DAYS FROM SHOP DRAWING REVIEW TURNAROUND TIME FROM DATE OF RECEIPT. ALL SHOP DRAWINGS AND CUTSHEETS MARKED "REVIEW ONLY" SHALL BE RETURNED TO THE CONTRACTOR WITHIN TEN (10) WORK DAYS FROM DATE OF RECEIPT. CONTRACTOR SHALL ASSUME RESPONSIBILITY FOR ERRORS IN THEIR DRAWINGS.		14 THE GENERAL CONTRACTOR SHALL SUBMIT ALL FABRICATION SHOP DRAWINGS AND EQUIPMENT/FIXTURE CUTSHEETS TO SAA FOR REVIEW. CONTRACTOR SHALL PROVIDE THREE (3) COPIES. SAA SHALL HAVE TEN (10) WORK DAYS FROM SHOP DRAWING REVIEW TURNAROUND TIME FROM DATE OF RECEIPT. ALL SHOP DRAWINGS AND CUTSHEETS MARKED "REVIEW ONLY" SHALL BE RETURNED TO THE CONTRACTOR WITHIN TEN (10) WORK DAYS FROM DATE OF RECEIPT. CONTRACTOR SHALL ASSUME RESPONSIBILITY FOR ERRORS IN THEIR DRAWINGS.	
2 ALL RESILIENT BASE TO BE AS SPECIFIED ON SHEET A-2.0. ALL MASONRY WALLS AND DRYWALL SHALL HAVE SPECIFIED STRAIGHT VINYL BASE IN CARPETED AREAS AND COVE VINYL BASE IN RESILIENT AREAS UNLESS OTHERWISE NOTED.		2 ALL RESILIENT BASE TO BE AS SPECIFIED ON SHEET A-2.0. ALL MASONRY WALLS AND DRYWALL SHALL HAVE SPECIFIED STRAIGHT VINYL BASE IN CARPETED AREAS AND COVE VINYL BASE IN RESILIENT AREAS UNLESS OTHERWISE NOTED.		15 ALL PIPE AND CONDUIT PENETRATIONS THROUGH FIRE RATED PARTITIONS SHALL BE FULLY SEALED WITH APPROVED FIRE RATED CAULKING MATERIAL, AND ALL DUCTWORK FITTED WITH APPROPRIATELY SIZED FIRE DAMPERS.		15 THE GENERAL CONTRACTOR SHALL SUBMIT ALL FABRICATION SHOP DRAWINGS AND EQUIPMENT/FIXTURE CUTSHEETS TO SAA FOR REVIEW. CONTRACTOR SHALL PROVIDE THREE (3) COPIES. SAA SHALL HAVE TEN (10) WORK DAYS FROM SHOP DRAWING REVIEW TURNAROUND TIME FROM DATE OF RECEIPT. ALL SHOP DRAWINGS AND CUTSHEETS MARKED "REVIEW ONLY" SHALL BE RETURNED TO THE CONTRACTOR WITHIN TEN (10) WORK DAYS FROM DATE OF RECEIPT. CONTRACTOR SHALL ASSUME RESPONSIBILITY FOR ERRORS IN THEIR DRAWINGS.		15 THE GENERAL CONTRACTOR SHALL SUBMIT ALL FABRICATION SHOP DRAWINGS AND EQUIPMENT/FIXTURE CUTSHEETS TO SAA FOR REVIEW. CONTRACTOR SHALL PROVIDE THREE (3) COPIES. SAA SHALL HAVE TEN (10) WORK DAYS FROM SHOP DRAWING REVIEW TURNAROUND TIME FROM DATE OF RECEIPT. ALL SHOP DRAWINGS AND CUTSHEETS MARKED "REVIEW ONLY" SHALL BE RETURNED TO THE CONTRACTOR WITHIN TEN (10) WORK DAYS FROM DATE OF RECEIPT. CONTRACTOR SHALL ASSUME RESPONSIBILITY FOR ERRORS IN THEIR DRAWINGS.		15 THE GENERAL CONTRACTOR THE	

SPECIAL INSPECTIONS

THE OWNER SHALL PROVIDE FOR A SPECIAL INSPECTOR(S) WHO WILL PROVIDE SPECIAL INSPECTIONS OF THE CONSTRUCTION AS PRESCRIBED BY THE CODE, THE CONSTRUCTION DOCUMENTS, OR THE REFERENCED ICC-ESR APPROVAL REPORT. IN NO CASE SHALL THE REQUIREMENTS IN THE CONSTRUCTION DOCUMENTS PROVIDE FOR ANY LESS THAN THE MINIMUM REQUIREMENTS OF THE CODE OR ANY OTHER GOVERNING AUTHORITY. ANY SUCH DISCREPANCY SHALL BE BROUGHT TO THE IMMEDIATE ATTENTION OF THE ENGINEER. THE SPECIAL INSPECTOR SHALL BE QUALIFIED BY THE CITY OF LOS ANGELES TO PROVIDE INSPECTIONS OF THE SPECIFIC CONSTRUCTION OR OPERATION REQUIRED. PROOF OF SUCH QUALIFICATION SHALL BE PROVIDED TO THE ENGINEER PRIOR TO THE START OF INSPECTIONS. THE SPECIAL INSPECTOR SHALL FURNISH INSPECTION REPORTS TO THE BUILDING OFFICIAL, THE ENGINEER, ARCHITECT AND THE CONTRACTOR IN A TIMELY MANNER. ALL DISCREPANCIES BETWEEN THE INSPECTORS WORK AND THE CONTRACT DOCUMENTS SHALL BE BROUGHT TO THE IMMEDIATE ATTENTION OF THE CONTRACTOR FOR CORRECTION. THEN, IF NOT CORRECTED TO THE ENGINEER, ARCHITECT AND THE BUILDING OFFICIAL, THE SPECIAL INSPECTOR SHALL KEEP RECORDS SUCH THAT ALL CONCERNED PARTIES CAN IDENTIFY THE OUTSTANDING WORK THAT NEEDS CORRECTION AND SUCH THAT CORRECTED WORK IS RECORDED IN A TIMELY MANNER. THE SPECIAL INSPECTOR SHALL SUBMIT A FINAL SIGNED REPORT STATING THAT THE WORK REQUIRING SPECIAL INSPECTION WAS, TO THE BEST OF THE INSPECTOR'S KNOWLEDGE, IN GENERAL CONFORMANCE WITH THE APPROVED PLANS AND SPECIFICATIONS AND THE APPLICABLE WORKMANSHIP PROVISIONS OF THE CODE. IF NON-CONFORMING WORK REMAINS, THEN THIS WORK SHALL BE ITEMIZED AND NOTED IN THE REPORT. THE CONTRACTOR SHALL PROVIDE ACCESS TO THE WORK REQUIRING SPECIAL INSPECTION. THE CONTRACTOR SHALL PROVIDE A DESIGNATED AREA, ON SITE, FOR THE SPECIAL INSPECTOR TO RECEIVE CORRESPONDENCE AND AN AREA TO LEAVE CORRESPONDENCE FOR THE BUILDING OFFICIAL AND THE CONTRACTOR. THE CONTRACTOR SHALL DESIGNATE A QUALITY CONTROL INDIVIDUAL THAT SHALL ACT AS THE MAIN POINT OF CONTACT FOR THE INSPECTOR, ENGINEER AND ARCHITECT REGARDING INSPECTIONS ISSUES. A PRE-INSPECTION MEETING SHALL BE HELD AND ORGANIZED BY THE CONTRACTOR ONCE INSPECTION HAS STARTED. AS A MINIMUM, THE ENGINEER, SPECIAL INSPECTOR, ARCHITECT, BUILDING OFFICIAL, OWNER'S REPRESENTATIVE AND THE CONTRACTOR'S QUALITY CONTROL INDIVIDUAL SHALL BE INVITED TO ATTEND. THE PURPOSE OF THE MEETING WILL BE TO MEET EACH OTHER, CONFIRM THE SCOPE OF WORK FOR EACH DISCIPLINE, ESTABLISH COMMUNICATION PROTOCOLS AND ANSWER ANY QUESTIONS.

ITEMS REQUIRING SPECIAL INSPECTION			
NON-STRUCTURAL COMPONENTS			
INSPECTION TASK	FREQUENCY OF INSPECTION		
	CONTINUOUS	PERIODIC	
1. ARCHITECTURE COMPONENTS: ERECTION & FASTENING OF THE FOLLOWING: (SEE NOTES 1 AND 9)			X
a. EXTERIOR CLADDING (SEE NOTE 2)			X
b. INTERIOR & EXTERIOR NON BEARING WALLS (SEE NOTE 3)			X
c. INTERIOR & EXTERIOR VENEER (SEE NOTE 2)			X
d. ANCHORAGE OF ACCESS FLOORS			X
e. ANCHORAGE OF SUSPENDED CEILING GRIDS AND STORAGE RACKS 8'-0" IN HEIGHT (SEE NOTE 1)			X
1. ERECTION OF GLASS & 3/4" OF IN HEIGHT ABOVE AN ADJACENT GRADE OR WALKING SURFACE IN GLAZED CURTAIN WALLS, GLAZED STOREFRONTS, AND INTERIOR GLAZED PARTITIONS.			X
2. MECHANICAL COMPONENTS: INSTALLATION OF THE FOLLOWING (SEE NOTE 4)			X
a. ANCHORAGE OF ELECTRICAL EQUIPMENT FOR EMERGENCY OR STANDBY POWER SYSTEMS			X
b. ANCHORAGE OF ALL ELECTRICAL EQUIPMENT (SEE NOTE 6)			X
c. PIPING SYSTEMS THAT CARRY FLAMMABLE, COMBUSTIBLE, OR HIGHLY TOXIC PIPING SYSTEMS AND THEIR ASSOCIATED MECHANICAL UNITS			X
d. HVAC DUCTWORK THAT WILL CONTAIN HAZARDOUS MATERIALS			X
e. VIBRATION ISOLATION SYSTEMS WHERE THE MAXIMUM CLEARANCE (AIR GAP) BETWEEN THE EQUIPMENT SUPPORT FRAME AND RESTRAINT IS 4 X 0.25 INCHES			X
3. DURING FABRICATION AND INSTALLATION OF ISOLATOR UNITS AND ENERGY DISSIPATION DEVICES IF USED AS PART OF SEISMIC ISOLATION SYSTEM			X
NOTES:			
1. SPECIAL INSPECTION IS NOT REQUIRED FOR ARCHITECTURAL COMPONENTS 430 FEET IN HEIGHT ABOVE GRADE OR WALKING SURFACE.			
2. SPECIAL INSPECTION IS NOT REQUIRED FOR CLADDING AND VENEER WEIGHING 5 PSF OR LESS.			
3. SPECIAL INSPECTION IS NOT REQUIRED FOR INTERIOR NON-BEARING WALLS WEIGHING 515 PSF.			
4. IN STRUCTURES ASSIGNED TO SEISMIC DESIGN CATEGORY C, D, E, OR F			
5. IN STRUCTURES ASSIGNED TO SEISMIC DESIGN CATEGORY D, E, OR F			
6. IN STRUCTURES ASSIGNED TO SEISMIC DESIGN CATEGORY E OR F			
7. SUSPENDED CEILINGS AND ANCHORAGE SHALL BE INSTALLED AND INSPECTED IN ACCORDANCE PER THE SPECIFIED ICC-ESR #1308.			
STRUCTURAL ANCHORS			
INSPECTION TASK	FREQUENCY OF INSPECTION		
	CONTINUOUS	PERIODIC	
1. POST INSTALLED ANCHORS:			
a. EXPANSION ANCHORS		X	
b. ADHESIVE ANCHORS		X	
c. POWDER DRIVEN FASTENERS			X
2. ANCHORAGE OF STORAGE RACKS ≥ 8'-0" IN HEIGHT			X



26 00 00 ELECTRICAL CONTINUED

- 10 THE ELECTRICAL CONTRACTOR SHALL PROVIDE ALL TEMPORARY LIGHTING AND ELECTRICAL SERVICE FOR ALL TRADES AS REQUIRED.
- 11 ALL ELECTRICAL, TELEPHONE RECEPTACLES AND LIGHT FIXTURES SHALL BE LOCATED AS DIMENSIONED ON SAA PLANS.
- 12 ALL NEW OUTLETS ON COLUMNS WILL BE CENTERED ON FACE SHOWN, UNLESS OTHERWISE NOTED.
- 13 POWER AND TELEPHONE OUTLETS SHOWN ON PLANS ARE NOT INCLUSIVE OF ALL OUTLETS REQUIRED BY OWNER. CONTRACTOR SHALL VERIFY WITH OWNER ALL REQUIRED OUTLETS PRIOR TO COMPLETING WALL CONSTRUCTION.
- 14 THE ELECTRICAL CONTRACTOR SHALL PROVIDE ALL POWER WIRING. ALL ELECTRICAL WIRING SHALL BE PLACED IN CONDUIT.
- 15 UNLESS OTHERWISE NOTED, ALL OUTLETS SIDE BY SIDE SHALL BE 6" FROM CENTER OF PLATE WITH POSITIONING DIMENSIONS CENTERED BETWEEN.
- 16 ALL ELECTRICAL AND TELEPHONE WIRING CONDUIT SHALL BE CONCEALED IN PARTITIONS AND/OR CEILING.
- 17 THE ELECTRICAL AND/OR GENERAL CONTRACTOR SHALL PROVIDE ALL CUTTING AND PATCHING OF ALL CHASES IN FLOORS, WALLS, AND CEILINGS, AS REQUIRED.
- 18 PROVIDE NEW BLANK COVER PLATES FOR ABANDONED OUTLET LOCATIONS.
- 19 CONVENIENCE RECEPTACLES SHALL BE DUPLEX TYPE RATED 15 AMP, 125 V., GROUNDING TYP., UNLESS OTHERWISE NOTED.
- 20 THE ELECTRICAL CONTRACTOR WILL COORDINATE HIS WORK WITH THE AIR CONDITIONING ENGINEER AND CONTRACTOR PRIOR TO EXECUTING HIS WORK.
- 21 AS IT RELATES TO THIS SET OF DOCUMENTS A DEDICATED CIRCUIT (DC) SHALL BE A SINGLE CIRCUIT WITH MULTIPLE OUTLETS DEDICATED TO A SPECIFIC EQUIPMENT USAGE.
- 22 ELECTRICAL CONTRACTOR TO FIELD VERIFY THAT ALL CIRCUITS AT THE MAIN PANEL ARE ADEQUATE FOR NEW REQUIREMENTS, AND SHALL INSTALL NEW CONDUIT, CIRCUITS, AND PANELS IF REQUIRED.
- 23 ALL EXPOSED ELECTRICAL DEVICES, I.E. SWITCHES, STROBES, OUTLETS, WALL TELEPHONE MOUNTS, ETC. AND ALL COVERPLATES TO MATCH "BLDG. STD.".
- 24 GENERAL CONTRACTOR IS TO VERIFY THE POWER REQUIREMENT AND CIRCUITING OF ANY SPECIALTY EQUIPMENT DURING ROUGH IN ELECTRICAL TO INSURE THE PROPER VOLTAGE AND CIRCUIT CONFIGURATION.
- 25 GENERAL CONTRACTOR IS TO HAVE FURNITURE VENDOR APPROVE ALL POWER AND TELEPHONE FEEDS FOR WORKSTATIONS PRIOR TO INSTALLATION. G.C. IS TO HAVE FURNITURE VENDOR APPROVE ALL ELECTRICAL AND DATA IN PRIVATE OFFICES PRIOR TO INSTALLATION.
- 26 FURNITURE VENDOR FOR EITHER WORKSTATIONS OR CASEWORK SHALL FIELD VERIFY VOLTAGE TO VERIFY CLEAR DIMENSIONS REQUIRED FOR FURNITURE PRIOR TO ORDERING FURNITURE. DO NOT SCALE THE DRAWINGS.
- 27 CONTRACTOR MUST COORDINATE ALL ELECTRICAL OUTLETS FOR FURNITURE WITH FURNITURE CONTRACTOR BEFORE PLACEMENT IN FIELD.
- 28 CONTRACTOR SHALL PROVIDE ELECTRICAL DRAWINGS STAMPED AND SIGNED BY LICENSED ENGINEER. PROVIDE COMPLETE WORKING DRAWINGS, CALCULATIONS AND DESCRIPTIVE DATA AS REQUIRED TO OBTAIN PERMITS FOR TENANT ELECTRICAL WORK. (DOES NOT ALWAYS APPLY)
- 29 LABEL ALL JUNCTION BOXES WITH CIRCUITS. LABEL PANEL WITH PREPRINTED TYPEWRITTEN PANEL SCHEDULE.
- 30 ALL CONDUIT SHALL BE EMT OR FLEX, NO BX OR PREWIRED CABLE ALLOWED.
- 31 ALL ELECTRICAL OUTLETS TO BE 120V, SINGLE PHASE AND MINIMUM 15 AMPS 3-WIRE GROUNDING WITH 1/2" CONDUIT. (UNLESS OTHERWISE NOTED)
- 32 PROVIDE SUPPORT FOR ALL CONDUITS ABOVE THE CEILING AS REQUIRED PER CODE.
- 33 ENSURE THAT ROOM SEPARATION OF LIGHTING IS MAINTAINED BY PROVIDING SWITCHING REQUIRED TO ACCOMPLISH THIS.
- 34 ELECTRICAL ENGINEER WILL BE RESPONSIBLE FOR EMERGENCY LIGHTING CALCULATIONS AND SPECS.
- 35 IF LIGHT FIXTURES ARE TO BE RELIEVED/RELOCATED, CONTRACTOR SHALL CLEAN & RE-LAMP TO MATCH. ALL LIGHTS AND FIXTURES OF THE SAME TYPE (NEW AND EXISTING) SHALL HAVE MATCHING LAMPS.
- 36 ALL SWITCHING AND LIGHTING LAYOUTS SHALL COMPLY WITH TITLE 24.
- 37 VERIFY QUANTITY OF LIGHT FIXTURES BETWEEN ARCHITECTURAL DRAWINGS AND ENGINEERING DRAWINGS. IF QUANTITY IS DIFFERENT NOTIFY ARCHITECT DURING BIDDING.

26 52 00 - SAFETY LIGHTING

- 1 GENERAL CONTRACTOR SHALL PROVIDE AN EMERGENCY EXIT AND EXIT LIGHTING SYSTEM AS REQUIRED BY GOVERNING JURISDICTIONS.
- 2 GENERAL CONTRACTOR TO PROVIDE EXIT SIGNS READILY VISIBLE TO CLEARLY INDICATE THE DIRECTION OF EGRESS TRAVEL. EXIT SIGNS SHALL BE PROPERLY ILLUMINATED. (2016 CBC 1013.5 AND 1013.6) ALL EXIT SIGN GRAPHICS, ILLUMINATION, AND POWER SOURCE MUST COMPLY WITH (2016 CBC 1013.5 AND 1013.6)
- 3 CONTRACTOR MUST COMPLY WITH (2016 CBC 1013.5 AND 1013.6) FOR THE EXIT SIGN GRAPHIC, ILLUMINATION, AND POWER SOURCE.
- 4 THE MEANS OF EGRESS, INCLUDING THE EXIT DISCHARGE SHALL BE ILLUMINATED AT ALL TIMES THE BUILDING SPACE SERVED BY THE MEANS OF EGRESS IS OCCUPIED. THE MEANS OF EGRESS ILLUMINATION LEVEL SHALL NOT BE LESS THAN 1 FOOT-CANDLE (11-LUX) AT THE WALKING SURFACE LEVEL. (2016 CBC 1008.1, 1008.2)
- 5 EXIT ILLUMINATION SHALL COMPLY WITH 2016 CBC SECTION 1008 AND 1013.
- 6 EXIT SIGNS SHALL BE INSTALLED AT REQUIRED EXIT DOORWAYS AND WHERE OTHERWISE NECESSARY TO CLEARLY INDICATE THE DIRECTION OF EGRESS WHEN THE EXIT SERVES AN OCCUPANT LOAD OF 50 OR MORE.

EXCEPTION: MAIN EXTERIOR EXIT DOORS WHICH OBVIOUSLY AND CLEARLY ARE IDENTIFIABLE AS EXITS NEED NOT BE SIGNED WHEN APPROVED BY THE BUILDING OFFICIAL.
- 7 WHEN NECESSARY, THE FINAL LOCATION AND QUANTITY OF EXIT SIGNS SHALL BE DETERMINED BY THE FIRE DEPARTMENT PRIOR TO CONSTRUCTION OF ANY WORK.
- 8 THE COLOR AND DESIGN OF LETTERING, ARROWS AND OTHER SYMBOLS ON EXIT SIGN SHALL BE IN HIGH CONTRAST WITH THEIR BACKGROUND (3/4" X 6" LETTERS MIN.)

27 00 00 COMMUNICATIONS

- 1 ALL FIXTURES PROVIDED FOR DATA CABLING SHALL COMPLY WITH DATA CONSULTANT'S PERFORMANCE CRITERIA. (EG: CAT5, ECAT5, CAT6...)
- 2 ALL FIRE PREVENTION WIRING IS TO BE PLACED IN CONDUIT.
- 3 FIRE RATED TERLOM PLENUM CABLES SHALL BE USED FOR TELEPHONE AND ANY LOW VOLTAGE CIRCUITS NOT IN CONDUIT.
- 4 PROVIDE TELEPHONE OUTLET BOXES (WHERE SHOWN ON "ELECTRICAL/ TELEPHONE PLAN") AND ALL NECESSARY CONDUIT RUNS TO TELEPHONE EQUIPMENT AS REQUIRED.
- 5 ALL TELEPHONE WIRING CONDUIT SHALL BE CONCEALED IN PARTITIONS AND/OR CEILING.
- 6 PROVIDE CONDUIT FROM SERVER ROOM TO CEILING FOR HORIZONTAL CABLE DISTRIBUTION. DATA VENDOR TO CONFIRM SIZE AND QUANTITY OF CONDUITS.
- 7 CONTRACTOR TO COORDINATE TELEPHONE/ DATA CONDUIT SIZE REQUIREMENTS WITH CLIENTS TELEPHONE/ DATA VENDOR.
- 8 CONTRACTOR TO PROVIDE CONDUIT AND NECESSARY CONNECTIONS BETWEEN TENANT'S TELEPHONE EQUIPMENT AND BUILDING MAIN TELEPHONE CLOSET. SIZE AS REQUIRED BY TENANT VENDOR.

28 46 00 FIRE DETECTION AND ALARM

- 1 SMOKE DETECTORS SHALL BE INSTALLED IN TENANT SPACE BY LICENSED ALARM SYSTEMS CONTRACTOR, WORK SHALL BE CONNECTED TO EXISTING BUILDING SYSTEM.
- 2 REWORK FIRE/LIFE SAFETY SYSTEM AS REQUIRED TO COMPLY WITH 2016 NFPA 72.
- 3 PROVIDE EMERGENCY NOTIFICATION SYSTEM FOR THE HEARING AND VISUAL IMPAIRED PER A.D.A. REQUIREMENTS AND 2016 CBC 118-215.

10 00 00 SPECIALITIES

- 10 44 16 - FIRE EXTINGUISHERS
- 1 A PORTABLE FIRE EXTINGUISHER WITH A MINIMUM 2A10BC RATING SHALL BE PROVIDED EVERY 75' OF TRAVEL DISTANCE FROM ANY POINT WITHIN THE AREA DEFINED AS SCOPE OF WORK FOR THESE PLANS. PROVIDE FIRE EXTINGUISHERS AS REQUIRED BY FIRE DEPARTMENT FIELD INSPECTOR.

12 00 00 FURNISHINGS

- 12 21 00 - WINDOW BLINDS
- 1 CONTRACTOR IS TO PROVIDE BUILDING STANDARD BLINDS AT ALL EXTERIOR WINDOWS. CONTRACTOR IS VERIFY THE CONDITION OF THE EXISTING BLINDS PRIOR TO PRICING. PROVIDE A PRICE TO CLEAN ALL BLINDS. CONTRACTOR IS TO SEAL ALL BLINDS TO PREVENT DUST FROM COLLECTING. IF BLINDS ARE IN NEED OF REPLACEMENT OR MISSING PROVIDE A COST FOR NEW IN THESE LOCATIONS. VERIFY CONDITION OF ALL BLINDS AT WINDOWS PRIOR TO PRICING. ANY NEW BLINDS SHALL MATCH EXISTING, VERIFY MANUFACTURER, STYLE, COLOR AND MEASURING PRIOR TO PRICING. ANY NEW INTERIOR GLAZING IS TO BE PROVIDED WITH NEW BUILDING STANDARD BLINDS TO MATCH EXISTING.
- 2 REPAIR/REPLACE WINDOW COVERINGS WHERE NECESSARY, SEE SHEET A-2-D FOR SPECIFICATION

21 00 00 FIRE SUPPRESSION

- 1 EXISTING FIRE SPRINKLER SYSTEM IS BUILDING STANDARD U.O.N.
- 2 REWORK FIRE SPRINKLER SYSTEM AS REQUIRED TO ACCOMMODATE NEW CONSTRUCTION AND TO COMPLY WITH CURRENT CODE.
- 3 AT ALL GYPSUM BOARD CEILING AREAS USE FULLY CONCEALED SPRINKLER HEADS, COLOR SHALL BE WHITE.
- 4 EXTEND/MODIFY FIRE/LIFE SAFETY SYSTEM AS REQUIRED.
- 5 IT IS INTENDED THAT FIRE SPRINKLER SYSTEM SHALL BE DESIGN/BUILD BY GENERAL CONTRATOR WITH DEFERRED APPROVAL.
- 6 FIRE SPRINKLER PLANS MUST BE SUBMITTED TO THE CITY FOR REVIEW AND APPROVAL BY APPROPRIATELY LICENSED CONTRACTOR FOR BUILDING PERMIT ISSUANCE, AND PRIOR TO INSTALLATION OR MODIFICATION OF EXISTING SYSTEM.

22 00 00 PLUMBING

- 1 FURNISH AND INSTALL ALL PLUMBING ROUGH-INS, FIXTURES AND ACCESSORIES SHOWN ON ALL CONSTRUCTION PLANS AND DETAIL DRAWINGS UNLESS OTHERWISE NOTED.
- 2 THE PLUMBING CONTRACTOR SHALL SUBMIT CUTS OF ALL NEW FIXTURES, FITTINGS AND ACCESSORIES TO SHELMMER+ALGAZE-ASSOCIATES FOR REVIEW AND APPROVAL.
- 3 THE PLUMBING CONTRACTOR SHALL COORDINATE AND INSTALL HIS WORK IN ACCORDANCE WITH MANUFACTURERS PUBLISHED SPECIFICATIONS.
- 4 ALL EXISTING PLUMBING BEING ABANDONED SHALL BE CAPPED BEHIND EXISTING FINISHED SURFACES. EXISTING SURFACES SHALL BE PATCHED TO MATCH EXISTING SURROUNDING SURFACES IN MATERIAL AND FINISH. THE GENERAL CONTRACTOR SHALL ALSO INCLUDE IN HIS BID A COST FOR WORK FOR CEILING REMOVAL AND REINSTALLATION REQUIRED FOR PLUMBING WORK IN CEILING PLENUM OF FLOOR BELOW TO COMPLETE WORK ON FLOOR BEING RENOVATED.
- 5 THE PLUMBING CONTRACTOR SHALL COORDINATE HIS WORK WITH ALL OTHER TRADES.
- 6 FURNISH ALL VALVES AS INDICATED ON THE DRAWINGS OR AS MAY BE REQUIRED FOR THE PROPER CONTROL OF THE VARIOUS APPARATUS AND PRELINES INSTALLED UNDER THIS SECTION SO THAT ANY FIXTURES PIPE OR APPARATUS MAY BE CUT OFF FOR REPAIR WITHOUT INTERFERENCE OR INTERRUPTION OF THE SERVICE TO THE REST OF THE BUILDING.
- 7 BEFORE BEING COVERED UP OR BUILT-IN ALL PIPING SHALL BE TESTED AS REQUIRED BY THE AUTHORITIES HAVING JURISDICTION.
- 8 TOILET FLUSH CONTROLS PROVIDED AND INSTALLED AS PART OF THE WORK SHALL BE OPERABLE WITH ONE HAND AND SHALL NOT REQUIRE TIGHT GRASPING, PINCHING OR TWISTING OF THE WRIST. CONTROLS FOR THE FLUSH VALVES SHALL BE MOUNTED ON THE WIDE SIDE OF THE TOILET AREAS. NO MORE THAN 44" ABOVE THE FLOOR. THE FORCE REQUIRED TO ACTIVATE THE CONTROLS SHALL BE NOT GREATER THAN 5 POUNDS.
- 9 OTHER FLUSH CONTROLS PROVIDED AND INSTALLED AS PART OF THE WORK SHALL BE OPERABLE WITH ONE HAND, AND SHALL NOT REQUIRE TIGHT GRASPING, PINCHING, OR TWISTING OF THE WRIST AND SHALL BE MOUNTED NO MORE THAN 44" ABOVE THE FLOOR. THE FORCE REQUIRED TO ACTIVATE CONTROLS SHALL NOT BE GREATER THAN 5 POUNDS.
- 10 FAUCET CONTROLS OR OTHER PLUMBING FIXTURE OPERATING MECHANISMS SHALL BE OPERABLE WITH ONE HAND AND SHALL NOT REQUIRE TIGHT GRASPING, PINCHING, OR TWISTING OF THE WRIST. THE FORCE REQUIRED TO ACTIVATE THE CONTROLS SHALL BE NO GREATER THAN 5 POUNDS. LEVER OPERATED, PUSH TYPE AND ELECTRONICALLY CONTROLLED MECHANISMS ARE EXAMPLES OF ACCEPTABLE DESIGNS. SELF CLOSING VALVES ARE ALLOWED IF THE FAUCET REMAINS OPEN FOR AT LEAST 10 SECONDS.

23 00 00 HVAC

- 1 THE HVAC ENGINEER WILL PROVIDE NECESSARY ENGINEERING DRAWINGS TO REWORK ALL EXISTING EQUIPMENT.
- 2 SUBMIT SHOP DRAWINGS INDICATING ALL NEW WORK AND ALL EXISTING EQUIPMENT TO REMAIN INCLUDING DIFFUSERS, THERMOSTATS AND ANY REQUIRED ACCESS PANELS, TO SHELMMER+ALGAZE-ASSOCIATES. FOR REVIEW PRIOR TO PROCEEDING WITH FABRICATION AND/OR INSTALLATION OR RELOCATION.
- 3 THE HVAC CONTRACTOR SHALL BE RESPONSIBLE FOR FIELD SUPERVISION OF ALL THEIR WORK DURING INSTALLATION AND SHALL INSPECT ALL SYSTEMS FOR PROPER OPERATIONS AT COMPLETION OF THE JOB.
- 4 INTERIOR SPACES SHALL BE MECHANICALLY VENTILATED IN ACCORDANCE WITH THE LOCAL BUILDING CODE. PLANS SHOWING MECHANICAL VENTILATION SYSTEM WILL BE FILED IN ACCORDANCE WITH THE LOCAL BUILDING DEPARTMENT.
- 5 ANY BUILDING SERVICE SHUT DOWNS REQUIRED FOR THIS WORK SHALL BE REQUIRED IN WRITING BY THE HVAC CONTRACTOR AT LEAST 72 HOURS IN ADVANCE OF THE SHUT DOWN. THE HVAC CONTRACTOR SHALL OBTAIN APPROVAL FROM ALL AUTHORITIES HAVING JURISDICTION PRIOR TO SHUT DOWN. ANY SHUT DOWN AFFECTING THE NORMAL HVAC SERVICE OF OTHER BUILDING OCCUPANTS SHALL BE DONE ON OVERTIME AND OFF HOURS.
- 6 BALANCING OF ENTIRE SYSTEM SHALL BE DONE BY AN INDEPENDENT AIR BALANCE COMPANY. SUBMIT REPORT TO SHELMMER+ALGAZE-ASSOCIATES AND BUILDING OWNER.
- 7 ALL DUCT WORK SHALL BE INSULATED PER CODE REQUIREMENTS FOR THERMAL AND ACOUSTIC CONSIDERATIONS.
- 8 MECHANICAL VENTILATION IN TOILET ROOM SHALL PROVIDE ONE (1) COMPLETE AIR CHANGE EVERY FIFTEEN (15) MINUTES AND SHALL BE VENTED TO OUTSIDE AIR.
- 9 ALL NEW MATERIALS REQUIRED SHALL BE EQUAL TO OR BETTER IN QUALITY THAN THE EXISTING.
- 10 ALL NEW DIFFUSERS SHALL MATCH APPEARANCE OF EXISTING.
- 11 THE HEATING, VENTILATING, AND AIR CONDITIONING SYSTEMS SHALL ACCOMMODATE THE NEW OCCUPANCY. ALL ROOMS AND AREAS SHALL HAVE SUPPLY AND RETURN AIR. THERMOSTATS SHALL HAVE AUTOMATIC CHANGEOVER FEATURE. (NO MANUAL SWITCHING FROM HEATING TO COOLING CYCLES), WITH METAL, NON VISUAL, TAMPER PROOF COVERS.
- 12 PRIOR TO INSTALLATION, HVAC ZONES AND T-STAT LOCATIONS SHALL BE APPROVED BY TENANT & COORDINATED WITH FURNITURE PLANS AND WALL FINISH LOCATIONS.
- 13 CONTRACTOR TO VERIFY WITH ARCHITECT IF LINEAR DIFFUSER IS REQUIRED WHERE CEILING SYSTEM IS GYP. BOARD.
- 14 REWORK ALL EXISTING HVAC SYSTEM TO ACCOMMODATE NEW CONSTRUCTION.
- 15 FIRE DAMPERS OR DOORS SHALL BE PROVIDED WHERE AIR DUCTS PENETRATE FIRE RATED WALLS OR CEILING AS PER 2016 CBC SECTION 716. SMOKE DAMPERS SHALL BE PROVIDED WHERE AIR DUCTS PENETRATE FIRE RATED WALLS OR CEILING AS PER 2016 CBC SECTION 716.
- 16 THE GENERAL CONTRACTOR SHALL SUPPLY ALL RETURN AIR OPENINGS IN SLAB TO SLAB PARTITIONS ABOVE HANGING CEILINGS TO MATCH AREA CALCULATIONS REQUIREMENTS AS SHOWN ON ENGINEERING DRAWINGS. ALL OPENINGS IN DEMISING AND SOUND ATTENUATED WALLS TO HAVE SOUND BOOTS.
- 17 DESIGN/BUILD DOCUMENTS SHALL COORDINATE EXISTING DIFFUSER AND SPRINKLER HEAD LOCATIONS. CONTRACTOR TO RELOCATE DIFFUSERS AND/OR SPRINKLER HEADS AS REQUIRED BY BUILDING CODE. CONTRACTOR TO PROVIDE LOCATION LAYOUT TO SAA PRIOR TO INSTALLATION.

26 00 00 ELECTRICAL

- 1 THE CONTRACTOR SHALL COORDINATE ALL ELECTRICAL WORK WITH MANUFACTURERS SPECIFICATIONS.
- 2 THE WORK SHALL BE INSTALLED IN STRICT ACCORDANCE WITH THE REQUIREMENTS OF THE NATIONAL BOARD OF FIRE UNDERWRITERS, PUBLIC UTILITIES COMPANY, TELEPHONE COMPANY AND ALL OTHER AUTHORITIES HAVING JURISDICTION.
- 3 ALL NEW MATERIALS SPECIFIED SHALL COMPLY WITH THE STANDARDS OF THE UNDERWRITERS LABORATORIES, INC. IN EVERY CASE WHERE SUCH A PARTICULAR TYPE OF MATERIAL IS SPECIFIED, UNLESS OTHERWISE NOTED.
- 4 VERIFY LOCATION OF FLOOR MONUMENT CORES WITH SAA IN THE FIELD PRIOR TO THE START OF ANY CORING. REFER ALSO TO SECTION 01 73 29 - CUTTING AND PATCHING. (COORDINATE CORE LOCATION WITH MILLWORK AND FURNITURE LAYOUT). PROVIDE CONDUIT DISTRIBUTION FROM CORES TO WALL STUB-UPS. PROVIDE FIRE SAFING AND SMOKE SEALANT AT FLOOR PENETRATIONS AS REQUIRED.
- 5 PROVIDE FIRE CAULKING AND/OR ACOUSTICAL CAULKING AT OUTLETS AT ACOUSTICAL AND FIRE RATED PARTITIONS. TYPICAL DIMENSION RANGE GIVEN AT ALL PRIVATE OFFICES IS A GENERAL GUIDELINE. OUTLETS ON OTHER SIDE OF THE WALL SHOULD SHIFT, 6" TO 12" IN OPPOSITE DIRECTIONS.
- 6 NO "BACK-TO-BACK" OUTLETS ARE PERMITTED WITHIN A WALL. OUTLETS MUST BE STAGGERED IN LOCATION AND INSTALLED IN SEPARATE STUD CAVITIES.
- 7 REFER TO DETAIL ON SHEET A-0.1 FOR TYPICAL INSTALLATION HEIGHT OF ALL WALL MOUNTED DEVICES, SWITCHES, OUTLETS, AND THERMOSTATS. LOCATE TOP OF THERMOSTATS, PULL BOXES, CONTROL DEVICES AND SWITCHES/DIMMERS AT A MAXIMUM OF 48" ABOVE FINISHED FLOOR TO TOP OF OUTLET BOX. WHERE SWITCHES/DIMMERS ARE GANGED TOGETHER, PROVIDE A SINGLE PIECE COVERPLATE.
- 8 THE ELECTRICAL CONTRACTOR SHALL SUBMIT CUTSHEETS OF ALL FIXTURES AS DIRECTED.
- 9 THE ELECTRICAL CONTRACTOR SHALL COORDINATE ANY ELECTRICAL OR LIGHTING INSTALLATION INTO THE CABINET WORK WITH THE CABINET CONTRACTOR AS REQUIRED.

CONSTRUCTION SPECIFICATIONS

1. WALL MOUNTED FIRE EXTINGUISHER, REFER TO SPECIFICATION BELOW:
- MANF.: POTTER-ROEHEMER
- MODEL: PROVIDE CLASS "K" EXTINGUISHER AT KITCHEN; PROVIDE TYPE "ABC" IN DINING AREA.

EQUIPMENT SPECIFICATIONS

NOTE: SEE FOOD SERVICE, PLUMBING, AND ELECTRICAL EQUIPMENT SCHEDULE FOR SPECIFICATIONS.

PROJECT:

HIMALAYAN GRILL

SUITE 120
16400 PACIFIC COAST HWY
HUNTINGTON BEACH, CA 92649



interiors + architecture
CULVER CITY, CA • IRVINE, CA • LOS ANGELES, CA
SAN FRANCISCO, CA • ISELIN, NJ • NEW YORK, NY

6083 Bristol Parkway
Culver City, CA 90230
T 310.553.3252

18020 MacArthur Blvd., Suite 100
Irvine, CA 92612
T 949.724.8958

515 South Flower St., Suite 1200
Los Angeles, CA 90071
T 213.929.1400

535 Mission St., Suite 2027
San Francisco, CA 94105
T 415.390.6793

485C US Route 1 South, Suite 105
Iselin, NJ 08830
T 848.200.1200

711 3rd Ave., 6th Floor
New York, NY 10017
T 917.512.6688

www.saaia.com

STAMP AND SIGNATURE:

CONSULTANTS:



NOTE: GC TO REVIEW APPLICABLE NOTES.
MECHANICAL, PLUMBING & ELECTRICAL TO
REQUIRE SEPARATE PERMIT

DRAWINGS ISSUE

DATE	DESCRIPTION	DELTA
11/07/19	ISSUE FOR ENGINEERING	
11/25/19	ISSUE FOR PLAN CHECK	
01/21/20	BULLETIN 1 - PLAN CHECK CORRECTIONS & TENANT REVISIONS	⚠
02/10/20	BULLETIN 2 - PLAN CHECK CORRECTIONS	⚠
05/07/21	REVISION TO PERMIT	⚠
06/11/21	PLAN CHECK CORRECTIONS	⚠

DATE:	10/31/19
DRAWN:	RW
REVIEWED:	MP
PROJECT NO:	626085.01
SCALE:	AS NOTED

SHEET TITLE:

GENERAL NOTES AND
SPECIFICATIONS

SHEET NO:

A-0.3

UNREASONABLE HARDSHIP REQUEST - FORM A



Unreasonable Hardship Request – Form A

Project Address: 16400 PACIFIC COAST HIGHWAY, HUNTINGTON BEACH, CA 92648		Permit Number:	
Project Description/Location:		Permit Valuation: \$175,000	
Type: <input type="checkbox"/> Alteration <input type="checkbox"/> Structural Repair <input type="checkbox"/> Addition		*Adjusted Cost of Proposed Construction: \$140,000	
PATH OF TRAVEL REQUIREMENTS FOR AREA OF ALTERATION, STRUCTURAL REPAIR, OR ADDITION			
Accessible Features	Does existing feature meet accessibility standards of Chapter 11B of the current CBC?	Will this feature be replaced or altered to meet Chapter 11B of the current CBC?	If so, how much will be spent to make this feature accessible?
1. Accessible entrance	YES	NO	\$
2. Accessible route to the altered area	YES	NO	\$
3. Accessible restroom for each sex or a unisex restroom	NO	YES	\$ 35,000
4. Accessible telephones	NO	NO	\$
5. Accessible drinking fountains	NO	NO	\$
6. Other (Any of the below)			
A. Accessible parking spaces	YES		UNDER SEPARATE PERMIT #H2018-002074
B. Signs	YES		UNDER SEPARATE PERMIT #H2018-002074
C. Alarms	YES		UNDER SEPARATE PERMIT #H2018-002074
D. Other:	YES		UNDER SEPARATE PERMIT #H2018-002074
Cost of All Features Provided (A)	Summary of costs of Accessible Features Nos. 1-6 provided above.		\$ 35,000
Adjusted Cost of Proposed Construction (B)	Construction cost for all proposed work on this permit application except Accessible Features Nos. 1-6 provided above.		\$ 140,000
Percentage Upgrades Provided (A / B)	Cost of all Features Provided / Total Cost on Same Path of Travel.		22 %
Description of Access Features Provided: NEW ACCESSIBLE UNISEX RESTROOM			

Applicant Certification		
I certify that the above information is true and correct to the best of my knowledge and belief.		
Signature:	Date: 11.21.19	Company: SAA INTERIORS + ARCHITECTURE
Name (print): ROSEMARY WOOD	Address: 18600 MACARTHUR BLVD., SUITE 100	
Title: Architect of Record	City, State Zip: IRVINE, CA 92612	
Agent for: <input type="checkbox"/> Owner <input checked="" type="checkbox"/> Architect <input type="checkbox"/> Engineer <input type="checkbox"/> Contractor	Phone No.: 949.608.3718	

*If an area has been altered without providing an accessible path of travel to that area, and subsequent alterations of that area or a different area on the same path of travel are undertaken within three years of the original alteration, the total cost of alterations to the areas on that path of travel during the preceding three-year period shall be considered in determining whether the cost of making that path of travel accessible is disproportionate.

CONSTRUCTION & DEMOLITION DEBRIS WASTE DIVERSION WORKSHEETS

City of Huntington Beach Department of Community Development 2000 Main Street, Huntington Beach, CA 92648 Office: (714) 536 - 5241 Fax: (714) 374 - 1647		PROJECT ADDRESS PERMIT NUMBER DATE	
CONSTRUCTION & DEMOLITION DEBRIS WASTE DIVERSION WORKSHEET			
Pre-Project Waste Diversion Plan (non-shaded portion). Indicate diversion method with an 'X' in appropriate column along with the name of vendor/facility. Calculate anticipated diversion and landfill percentage of each material type. If you are sending mixed construction debris to a transfer station for sorting, enter the same destination for all materials in the mix. List deconstructed items for reuse on-site (donated / sold), on the next page. Include the approximate weight in the column for reusable items.			
Post-Project Waste Diversion Report (shaded portion). Enter actual weight in pounds for each category. Calculate weight column total and diversion rate. Keep all receipts for final report.			
If applicant is using Green Halo online tracking system, this worksheet (including Waste Diversion Plan & Waste Diversion Report) is NOT REQUIRED! Green Halo offers a free web-based Waste Management Plan and Project Tracking System which can be found by visiting https://www.greenhalosystems.com .			
WASTE DIVERSION PLAN (FOR PLAN CHECK ONLY)			
MATERIAL	REUSE	RECYCLE	WASTE
ASPHALT			
CONCRETE			
DIRT & ROCK (From previously undeveloped lots)			
AT LEAST 60% DIVERSION OF THE FOLLOWING MATERIALS. DIVERSION BASED ON AMOUNT OF THE COMBINED TOTAL WEIGHT OF MATERIALS BELOW.			
CARDBOARD			
CORRUGATED METAL			
BRICK MASONRY TILE			
METALS			
PLANT DEBRIS			
SHEETROCK (Not painted)			
CLEAN WOOD			
CEILING TILE			
PAINTED WOOD			
PAINTED DRYWALL			
REUSABLE ITEMS			
ROOFING			
OTHER DEBRIS			
OTHER DEBRIS			

Page 3 of 5

City of Huntington Beach Department of Community Development 2000 Main Street, Huntington Beach, CA 92648 Office: (714) 536 - 5241 Fax: (714) 374 - 1647		PROJECT ADDRESS PERMIT NUMBER DATE	
CONSTRUCTION & DEMOLITION DEBRIS WASTE DIVERSION WORKSHEET			
Reusable items such as cabinets, built-ins, framing lumber, siding, etc. are encouraged to be reused on-site. Please list accordingly.			
ITEM	USE LOCATION	OFF-SITE BENEFACTOR OR DECONSTRUCTION COMPANY	
	ON-SITE OFF-SITE		
	ON-SITE OFF-SITE		
	ON-SITE OFF-SITE		
WEIGHT CONVERSION FACTORS			
Use the following conversion factors as well as receipts from previous jobs to help you with your estimated diversion for the Waste Diversion Plan. The Waste Diversion Report is a record of your actual diversion and disposal. The Waste Diversion Report and receipts from landfills, transfer stations and recyclers must be available for review at your final building inspection.			
Asphalt paving, crushed = 1,380 lbs / cubic yard	Concrete, scraps, loose = 1,855 lbs / cubic yard		
Asphalt/shingles comp, loose = 418.5 lbs / cubic yard	Earth, loose = 2,052 lbs / cubic yard		
Brick, laid flat = 20 lbs / square foot flat	Fiberglass insulation, loose = 17 lbs / cubic yard		
Brick, loose = 120 lbs / cubic foot, 3,200 lbs / cubic yard	Sheetrock scrap, loose = 393.5 lbs / cubic yard		
Ceramic tile, scrap, loose = 1,214 lbs / cubic yard	Rock, crushed = 2,570 lbs / cubic yard		
Please submit three (3) copies of this worksheet with your building permit application and this worksheet shall be electronically placed / made a part of plans.			
For instructions on how to fill out this form, see "Waste Diversion Worksheet Instructions" located online at the Building Division website under Frequently Requested Forms.			
For more information, visit http://www.huntingtonbeachca.gov/government/departments/planning-building or contact the Building Division at (714) 536-5241.			

Page 4 of 5

City of Huntington Beach Department of Community Development 2000 Main Street, Huntington Beach, CA 92648 Office: (714) 536 - 5241 Fax: (714) 374 - 1647		PROJECT ADDRESS PERMIT NUMBER DATE	
CONSTRUCTION & DEMOLITION DEBRIS WASTE DIVERSION WORKSHEET LOCAL RECYCLING DEALERS / FACILITIES			
The categories of recyclable materials are as follows:			
• Construction and Demolition Materials: Brick, concrete, dirt, granite, gravel, pavement/asphalt and sand.			
• Green Wastes: Compost, grass clippings, leaves, pruning, and Christmas trees.			
• Glass: Beverage containers, crushed glass, and window panes.			
• Wood: Bark, boards, planks, chips, pallets, plywood, sawdust and shavings.			
Note: Although a company may designate the acceptance of materials in one or more categories, please call to verify the materials and quantities produced on your project are accepted. You may also visit Cal Recycle at http://www.calrecycle.ca.gov/condemo/recyclers/RecyclerSearch.aspx for other local dealers and facilities.			
Rainbow Disposal 17121 Nichols Ln, Huntington Beach, CA 92647, Phone #: (714) 847-3581		Huntington Beach Recycling 7632 Slater Ave, Huntington Beach, CA 92647, (714) 841-4885	
Rainbow Disposal 17121 Nichols Ln, Huntington Beach, CA 92647, Phone #: (714) 847-3581		Rainbow Disposal 17121 Nichols Ln, Huntington Beach, CA 92647, Phone #: (714) 847-3581	
Dan Copp Crushing Corp. 1120 N. Richfield Rd, Anaheim, CA 92807, (714) 777-6400		1035 East 4th St, Santa Ana, CA 92701 (714) 664-0159	
Aguinaga Company 16355 Construction Cir #W, Irvine, CA 92606, (949) 786-9558		R.J. Noble 15605 E. Lincoln Ave, Orange, CA 92665 (714) 637-1550	
(concrete, concrete blocks, asphalt only) 8200 Katella Ave Stanton, CA 90680, (714) 894-1988		TVI Gold Coast Recycling 7973 Irvine Blvd, Irvine, CA 92618 (949) 551-0363	
All Variety Metals, Inc 1016 Santiago St, Santa Ana, CA 92701 (714) 835-9235		Sunset Environmental 16122 Construction Cir #E, Irvine, CA 92606, (949) 654-1562	

Page 5 of 5

CONSTRUCTION & DEMOLITION DEBRIS WASTE DIVERSION WORKSHEETS

City of Huntington Beach Department of Community Development 2000 Main Street, Huntington Beach, CA 92648 Office: (714) 536 - 5241 Fax: (714) 374 - 1647		PROJECT ADDRESS PERMIT NUMBER DATE	
CONSTRUCTION & DEMOLITION DEBRIS RE-USE & RECYCLING PROGRAM			
Construction and Demolition (C & D) Debris Re-Use and Recycling Program			
When a project is covered by the updated Huntington Beach C & D Ordinance Section 8.21, it must recycle 65% of the debris it generates. Please review the table below for our current requirements.			
Planned Start Date	January 1st, 2017		
Covered projects	Effective January 1st, 2017 • Newly constructed building and demolition projects shall divert from landfills at least 65% of the construction materials generated during project. • All locally permitted additions and alterations to non-residential buildings or structures shall divert from landfills at least 65% of non-hazardous construction and demolition materials. • Additions and alterations to residential buildings that increase the structure's conditioned area, volume or size are also required to meet the 65% minimum diversion requirement.		
Materials required to be recycled	65% of all generated waste must be diverted / recycled per 2016 California Green Building Standards Code, Chapter 4, section 4.408 for all new residential and Chapter 5, section 5.408.1 - 5.408.3 and 5.713.8 - 5.713.8.3 for all non-residential new construction, additions and/or alterations. Please complete attached for C & D Debris Waste Log.		
How to recycle	Mixed C & D: All debris (no wet garbage) into one bin. Source-Separated: Separate by type.		
Who can haul debris	Mixed C & D: Permit-holder, self-haul or truck-haul, waste generator or franchised hauler. Source-Separated: Anyone		
Where debris may go	Mixed C & D: City of Huntington Beach approved Mixed C & D facility such as Rainbow Disposal or see attached for other approved local processing facilities. Source-Separated: any facility that accepts the material.		
Processing fee	Processing fee is currently being evaluated. Please continue to check with the Building Division counter staff for further updates.		
Security Deposit	Required security deposit is currently being evaluated. Please continue to check with the Building Division counter staff for further updates.		
Fines	Fines are currently being evaluated. Please continue to check with the Building Division counter staff for further updates.		
Documentation	Permit-holder must keep a waste log of all materials hauled away from project site, as well as all weight tickets of disposed and recycled material. The waste log must be submitted at permit issuance, framing inspection and prior to building final approval.		
How to comply	1. Register your project either online using Green Halo Systems or by completing the Waste Reduction Recycling Plan (WRRP) form attached. Make sure to enter the Green Halo project tracking number on the WRRP form. The Green Halo System is a FREE web-based system that will help you create your waste management plan, upload your recycling date throughout your construction process and generate your final report for project compliance. 2. Create waste diversion plan in Green Halo and print out Project Information page. Submit (3) copies of the Waste Diversion Form and (3) copy of the waste diversion plan print-out from Green Halo with your Building Permit Application. 3. Divert debris as specified on the plan and collect required documentation. Be sure to ask for construction debris receipts from transfer stations in order to qualify for diversion requirements. Upload recycling and disposal receipts to Green Halo. 4. Pre-Building Final: show the Building Inspector final Green Halo report demonstrating diversion rate compliance. Note, the final report is not required for single family renovations. NOTE: If you are unable to use Green Halo, complete the C & D Debris Waste Diversion Worksheet instead. Fill-out the Waste Diversion Plan (non-shaded) portion of the document prior to starting your project and the Waste Diversion Report (shaded) portion of the document prior to final inspection. Assistance: For assistance with the Diversion Plan Worksheet, contact the Building Division at (714) 536 - 5241. For Green Halo Systems, please visit www.greenhalosystems.com or call (888) 525 - 3301 (M-F 8am to 5pm).		

Page 1 of 5

City of Huntington Beach Department of Community Development 2000 Main Street, Huntington Beach, CA 92648 Office: (714) 536 - 5241 Fax: (714) 374 - 1647		PROJECT ADDRESS PERMIT NUMBER DATE	
CONSTRUCTION & DEMOLITION DEBRIS RE-USE & RECYCLING PROGRAM			
This form must be complete for the following types of projects:			
• Newly constructed building and demolition projects shall divert from landfills at least 65% of the construction materials generated during project.			
• All locally permitted additions and alterations to non-residential buildings or structures shall divert from landfills at least 65% of non-hazardous construction and demolition materials.			
• Additions and alterations to residential buildings that increase the structure's conditioned area, volume or size are also required to meet the 65% minimum diversion requirement.			
WRRP must be submitted and APPROVED prior to issuance of building permits. Incomplete forms will be returned to applicant and may delay issuance of permit(s). Each building requires a separate WRRP. Deliver WRRP with permit application to the Building Division permit counter, 2000 Main St, 3rd Floor, Huntington Beach, CA 92648. Allow 5-10 business days for WRRP processing. You may call (714) 536 - 5241 with inquiries regarding this form.			
DO NOT ATTACH ADDITIONAL ITEMS			
Permit #: B-2019-008094 Address: SUITE 120, 16400 PACIFIC COAST HIGHWAY, HUNTINGTON BEACH, CA 92648 CONTACT NAME: Courtney Parks COMPANY: Pendulum Property Partners TITLE: Director of Property and Construction Contact Mailing Address: 5 Peters Canyon Road, Suite 350 City: Irvine State: CA Zip: 92606 Phone #: 949-449-1383 Fax #: Email: cparks@pendulumPP.com			
For lines 1, 2 and 3, please check only 1 item for each:			
1) Project Type: <input checked="" type="checkbox"/> New Construction <input checked="" type="checkbox"/> Addition/Alteration <input type="checkbox"/> Demolition			
2) Building Type: <input checked="" type="checkbox"/> Non-residential <input type="checkbox"/> Low-rise residential/Duplex <input type="checkbox"/> Apartment/Multi-Family			
3) Tenant Improvement (check one): <input checked="" type="checkbox"/> Yes <input type="checkbox"/> No			
4) Size of Project: ±7,573 sq. ft. Project Valuation: \$165,000			
5) Estimated Start Date / / Estimated Completion Date / /			
6) Compliance method (Check one and provide required information)			
<input checked="" type="checkbox"/> Green Halo System (Enter tracking number) <input type="checkbox"/> Waste Diversion Plan Worksheet (if not using Green Halo)			
7) Briefly describe project (i.e.: renovate warehouse, remodel office, etc.):			
8) How will scrap or waste material be handled to ensure salvage, re-use or recycling?			
9) How will employees and sub-contractors be notified of recycling proposed plan and goals?			

Page 2 of 5

PROJECT:
HIMALAYAN GRILLSUITE 120
16400 PACIFIC COAST HWY
HUNTINGTON BEACH, CA 92649saa
interiors + architecture
CULVER CITY, CA • IRVINE, CA • LOS ANGELES, CA
SAN FRANCISCO, CA • ISELIN, NJ • NEW YORK, NY6083 Bristol Parkway T 310.553.3252
Culver City, CA 90230
18600 MacArthur Blvd., Suite 100 T 949.724.8958
Irvine, CA 92612
515 South Flower St., Suite 1200 T 213.929.1400
Los Angeles, CA 90071
535 Mission St., Suite 2027 T 415.390.6793
San Francisco, CA 94105
485C US Route 1 South, Suite 105 T 848.200.1200
Iselin, NJ 08830
711 3rd Ave., 6th Floor T 917.512.6688
New York, NY 10017

www.saaia.com

STAMP AND SIGNATURE:


CONSULTANTS:

DRAWINGS ISSUE		
DATE	DESCRIPTION	DELTA
11/07/19	ISSUE FOR ENGINEERING	
11/25/19	ISSUE FOR PLAN CHECK	
01/21/20	BULLETIN 1 - PLAN CHECK CORRECTIONS & TENANT REVISIONS	△
02/10/20	BULLETIN 2 - PLAN CHECK CORRECTIONS	△
05/07/21	REVISION TO PERMIT	△
06/11/21	PLAN CHECK CORRECTIONS	△
DATE: 10/31/19		
DRAWN: RW		
REVIEWED: MP		
PROJECT NO: 626085.01		
SCALE: AS NOTED		
SHEET TITLE:		

GENERAL NOTES AND
SPECIFICATIONS


SHEET NO:

A-0.3.1

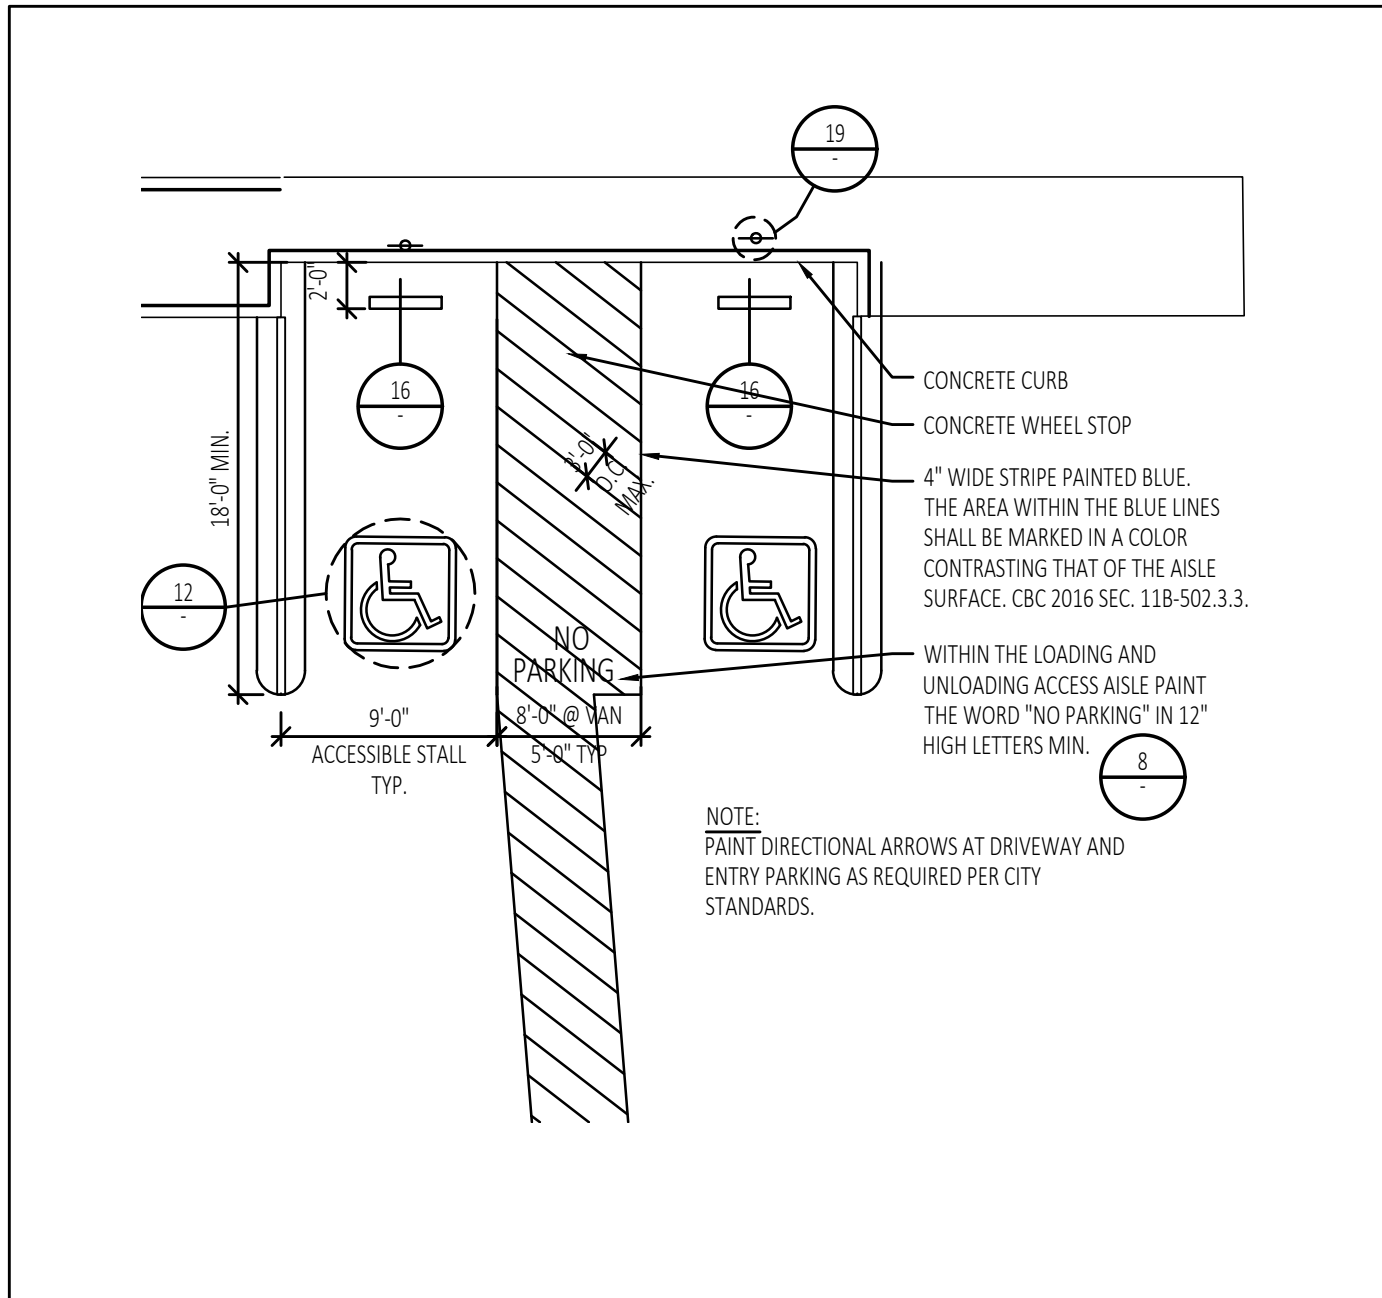


EXISTING ACCESSIBLE PARKING STALL

SCALE: 1/8" = 1'-0"

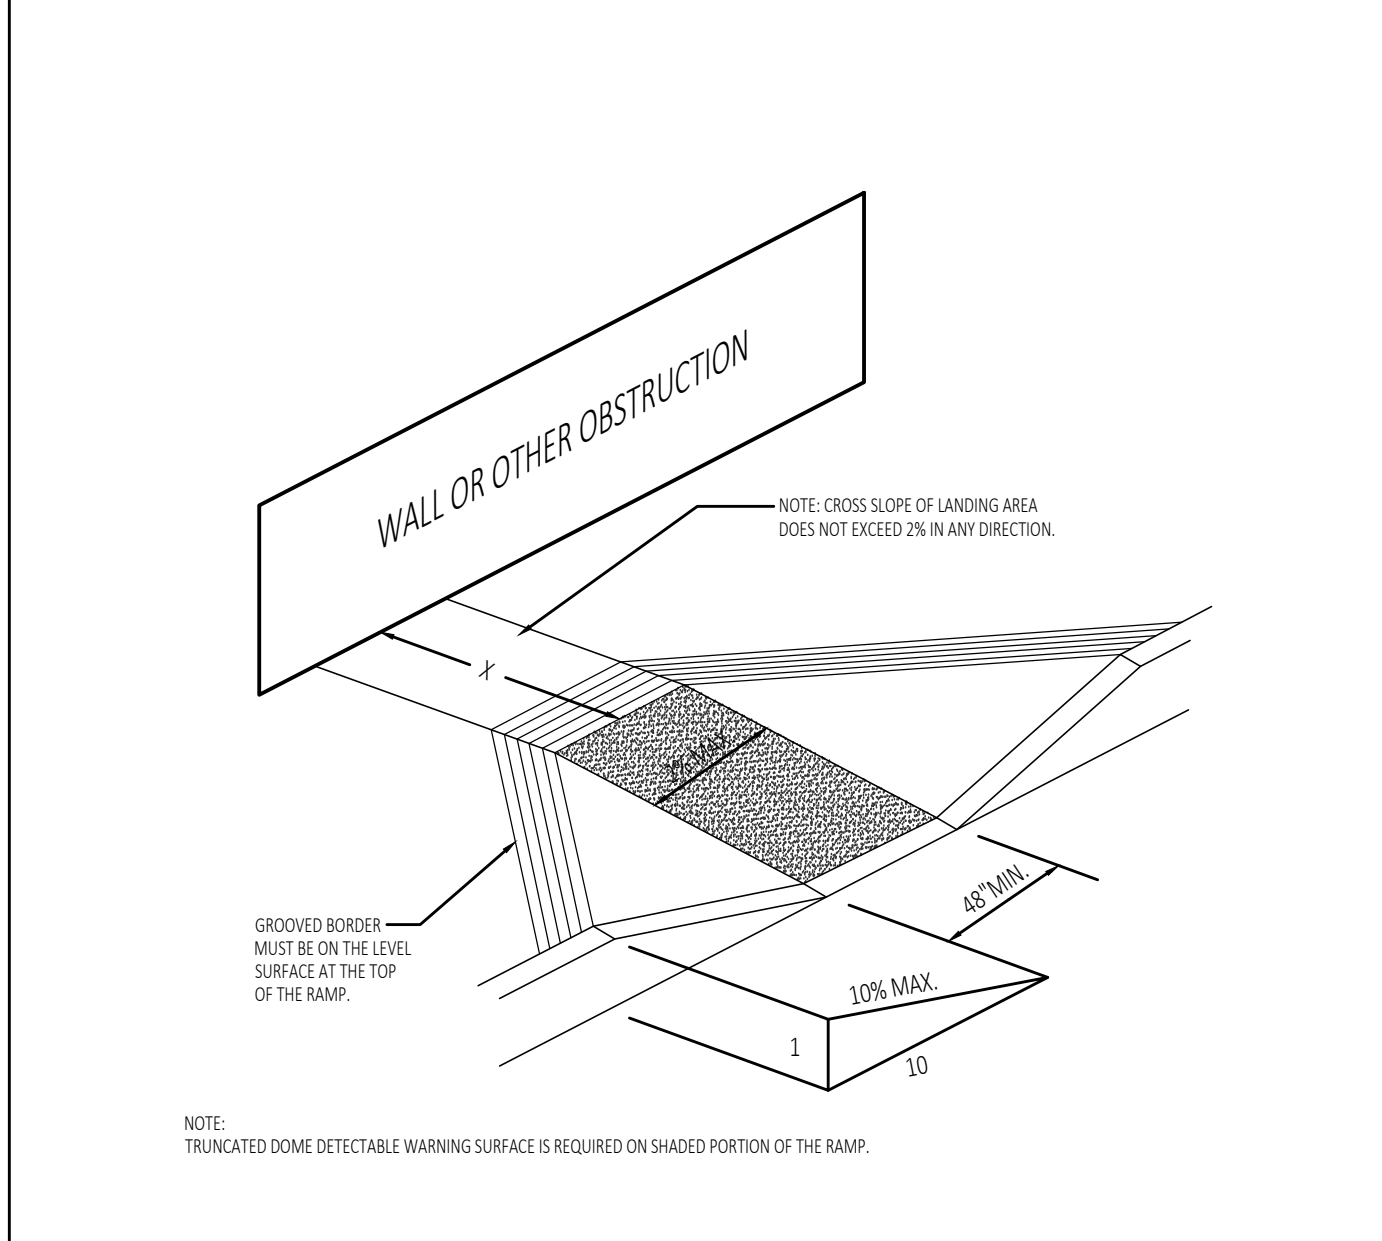


(E) BUILT-IN RAMPS AND CURB-CUT RAMPS

SCALE: 1/8" = 1'-0"

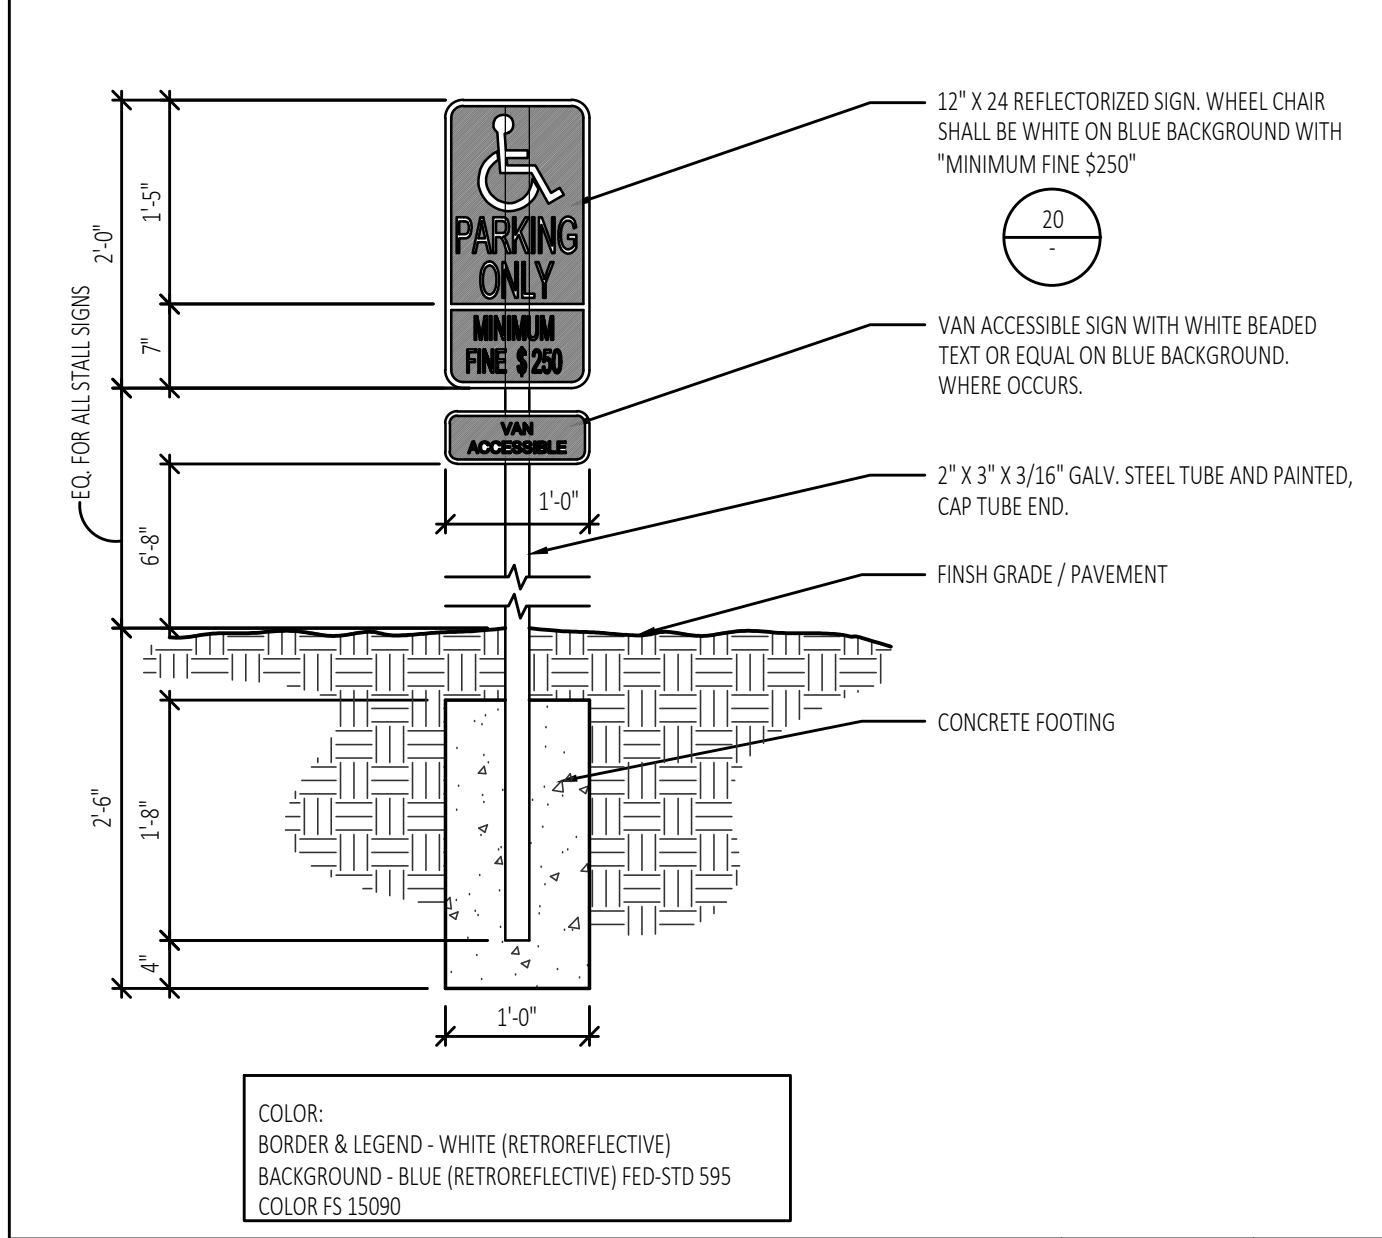


VAN ACCESSIBLE SIGNAGE

SCALE: 3/4" = 1'-0"

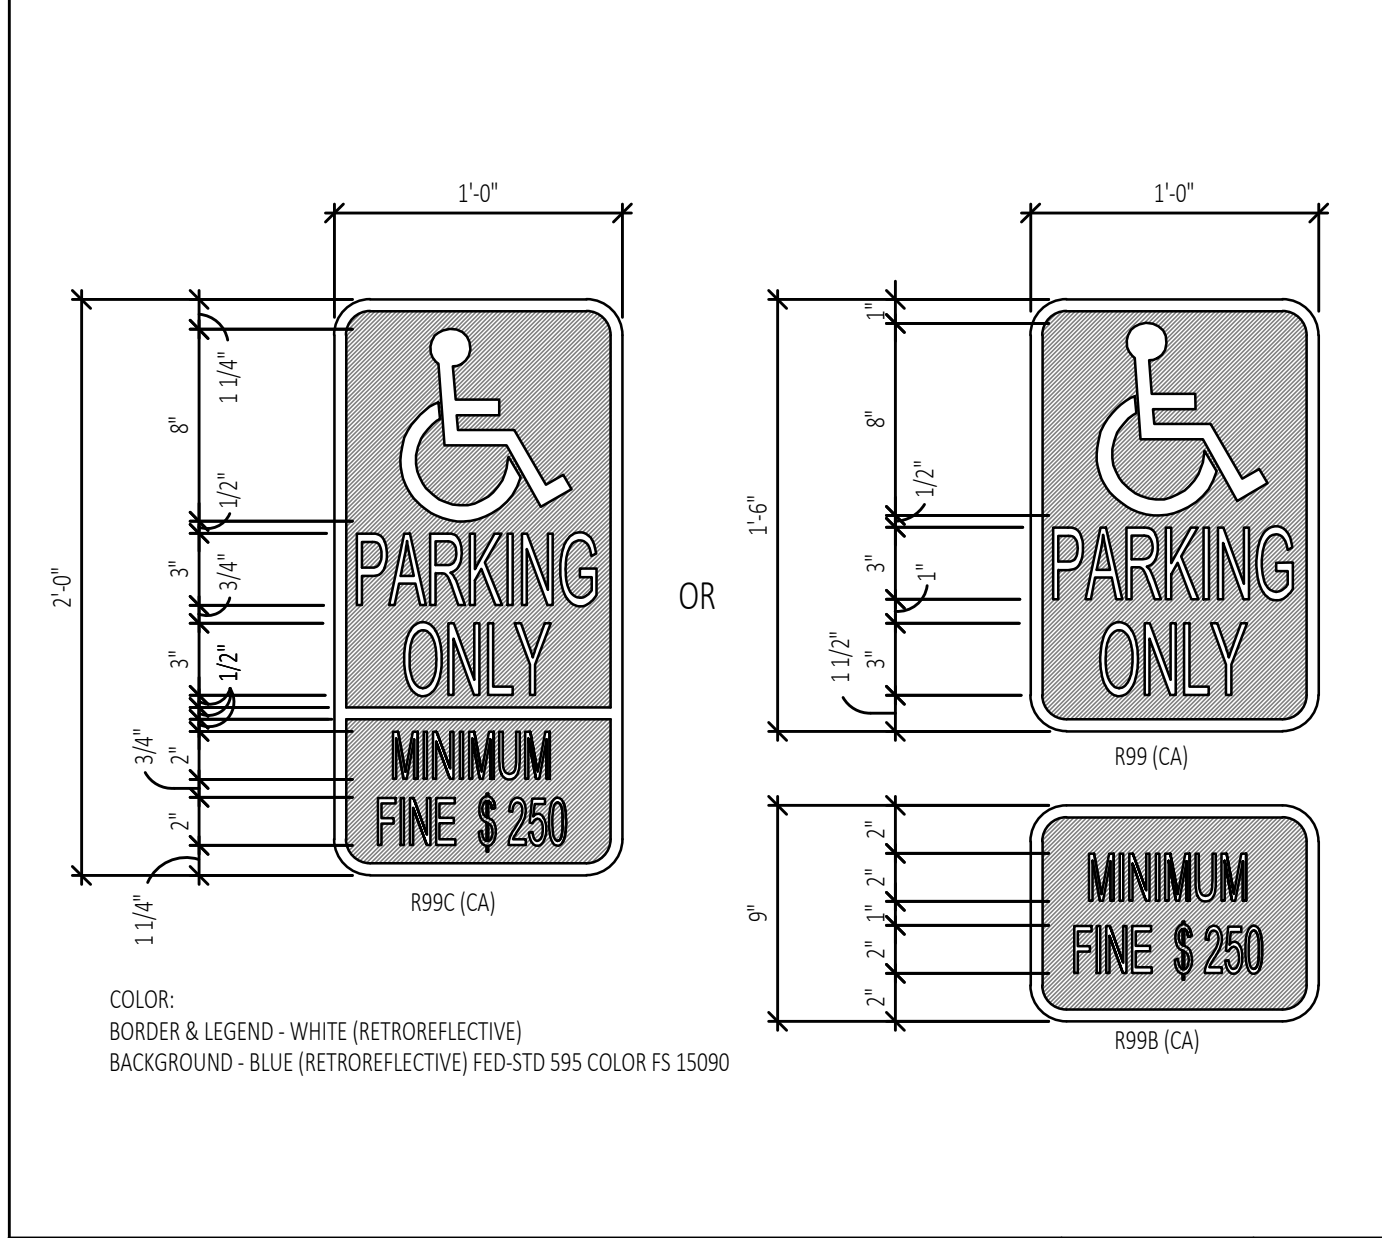


ACCESSIBLE SIGNS

SCALE: 1/2" = 1'-0"

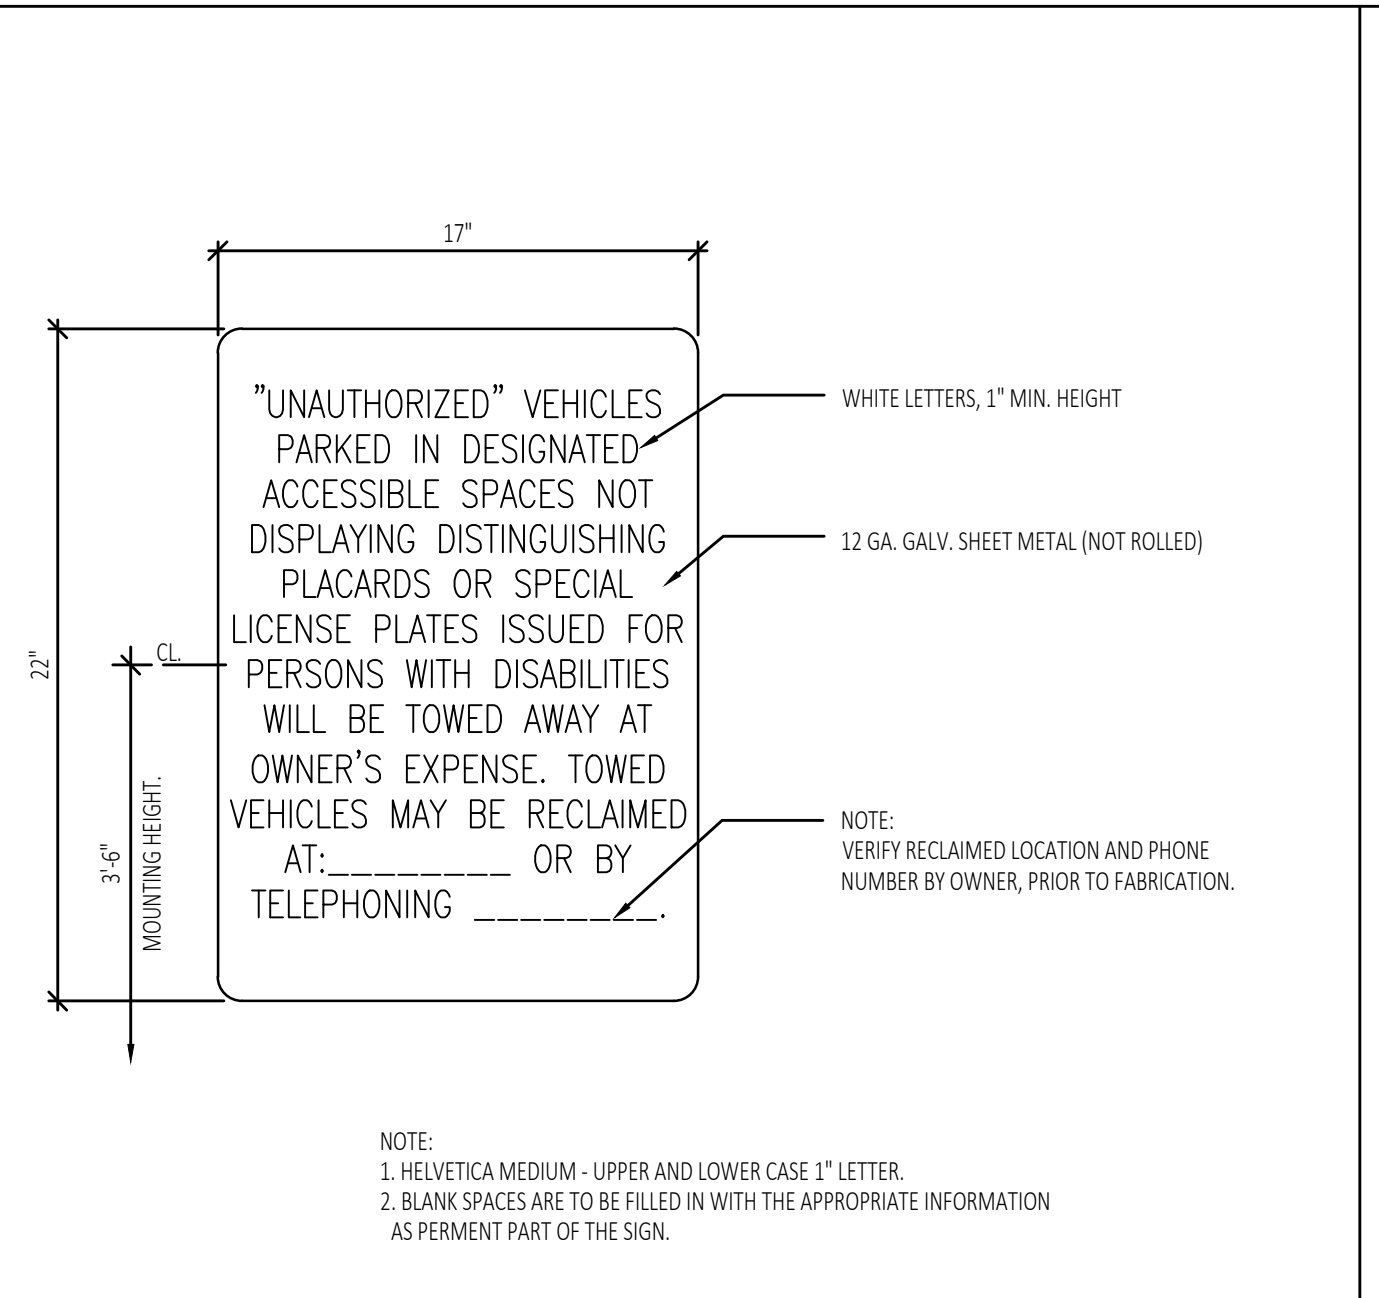


ENTRY SIGNAGE

SCALE: 1/2" = 1'-0"

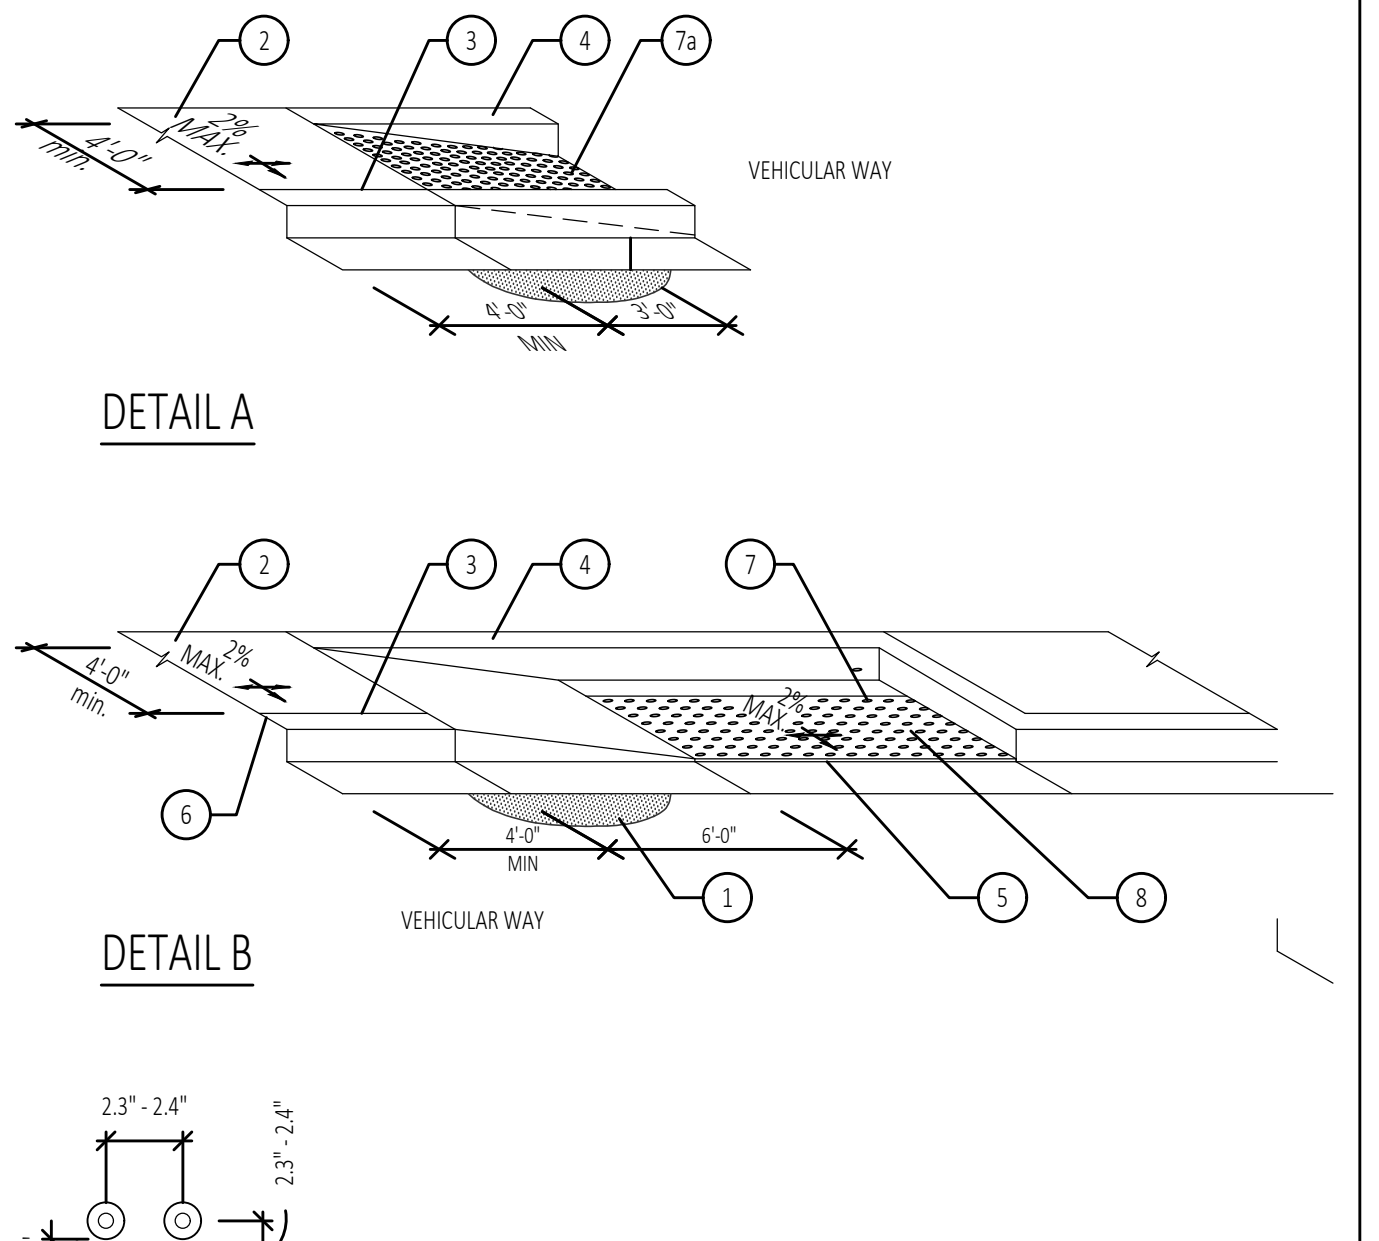


(E) CURB TRUNCATED DOMES, RAMP, AND GROOVES

SCALE: 1/2" = 1'-0"

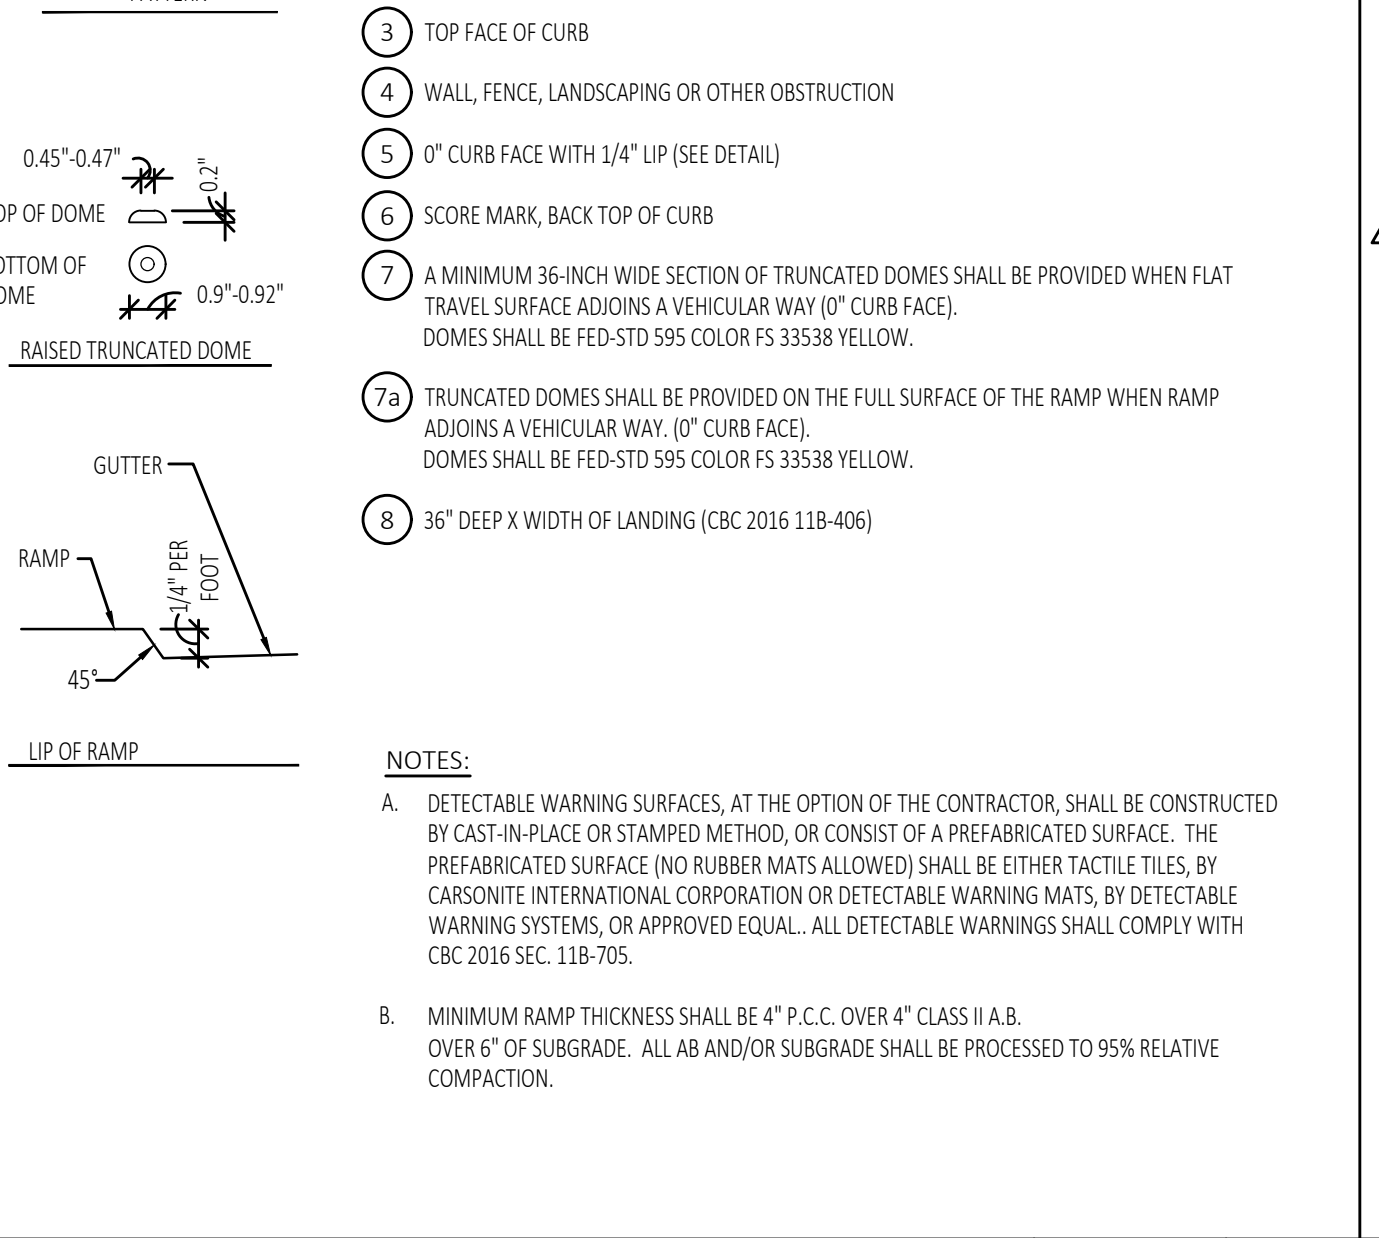


CONCRETE WHEEL STOP

SCALE: 1/2" = 1'-0"

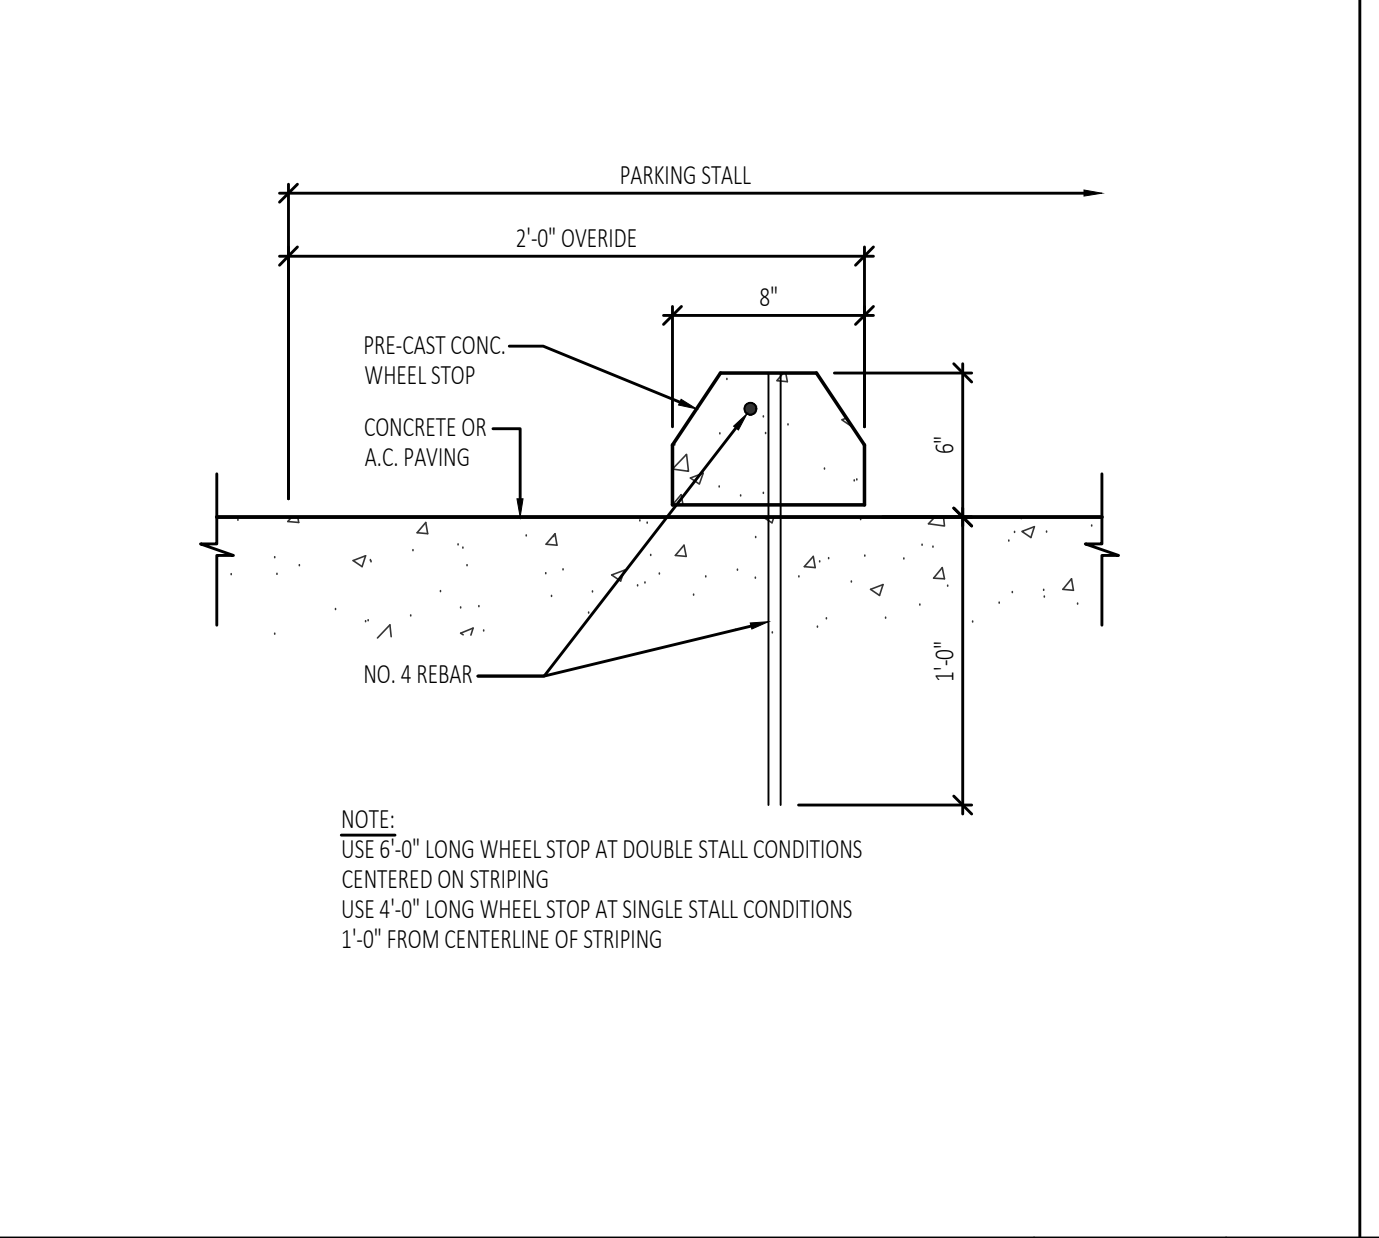


PARKING SPACE EMBLEM

SCALE: 1/2" = 1'-0"

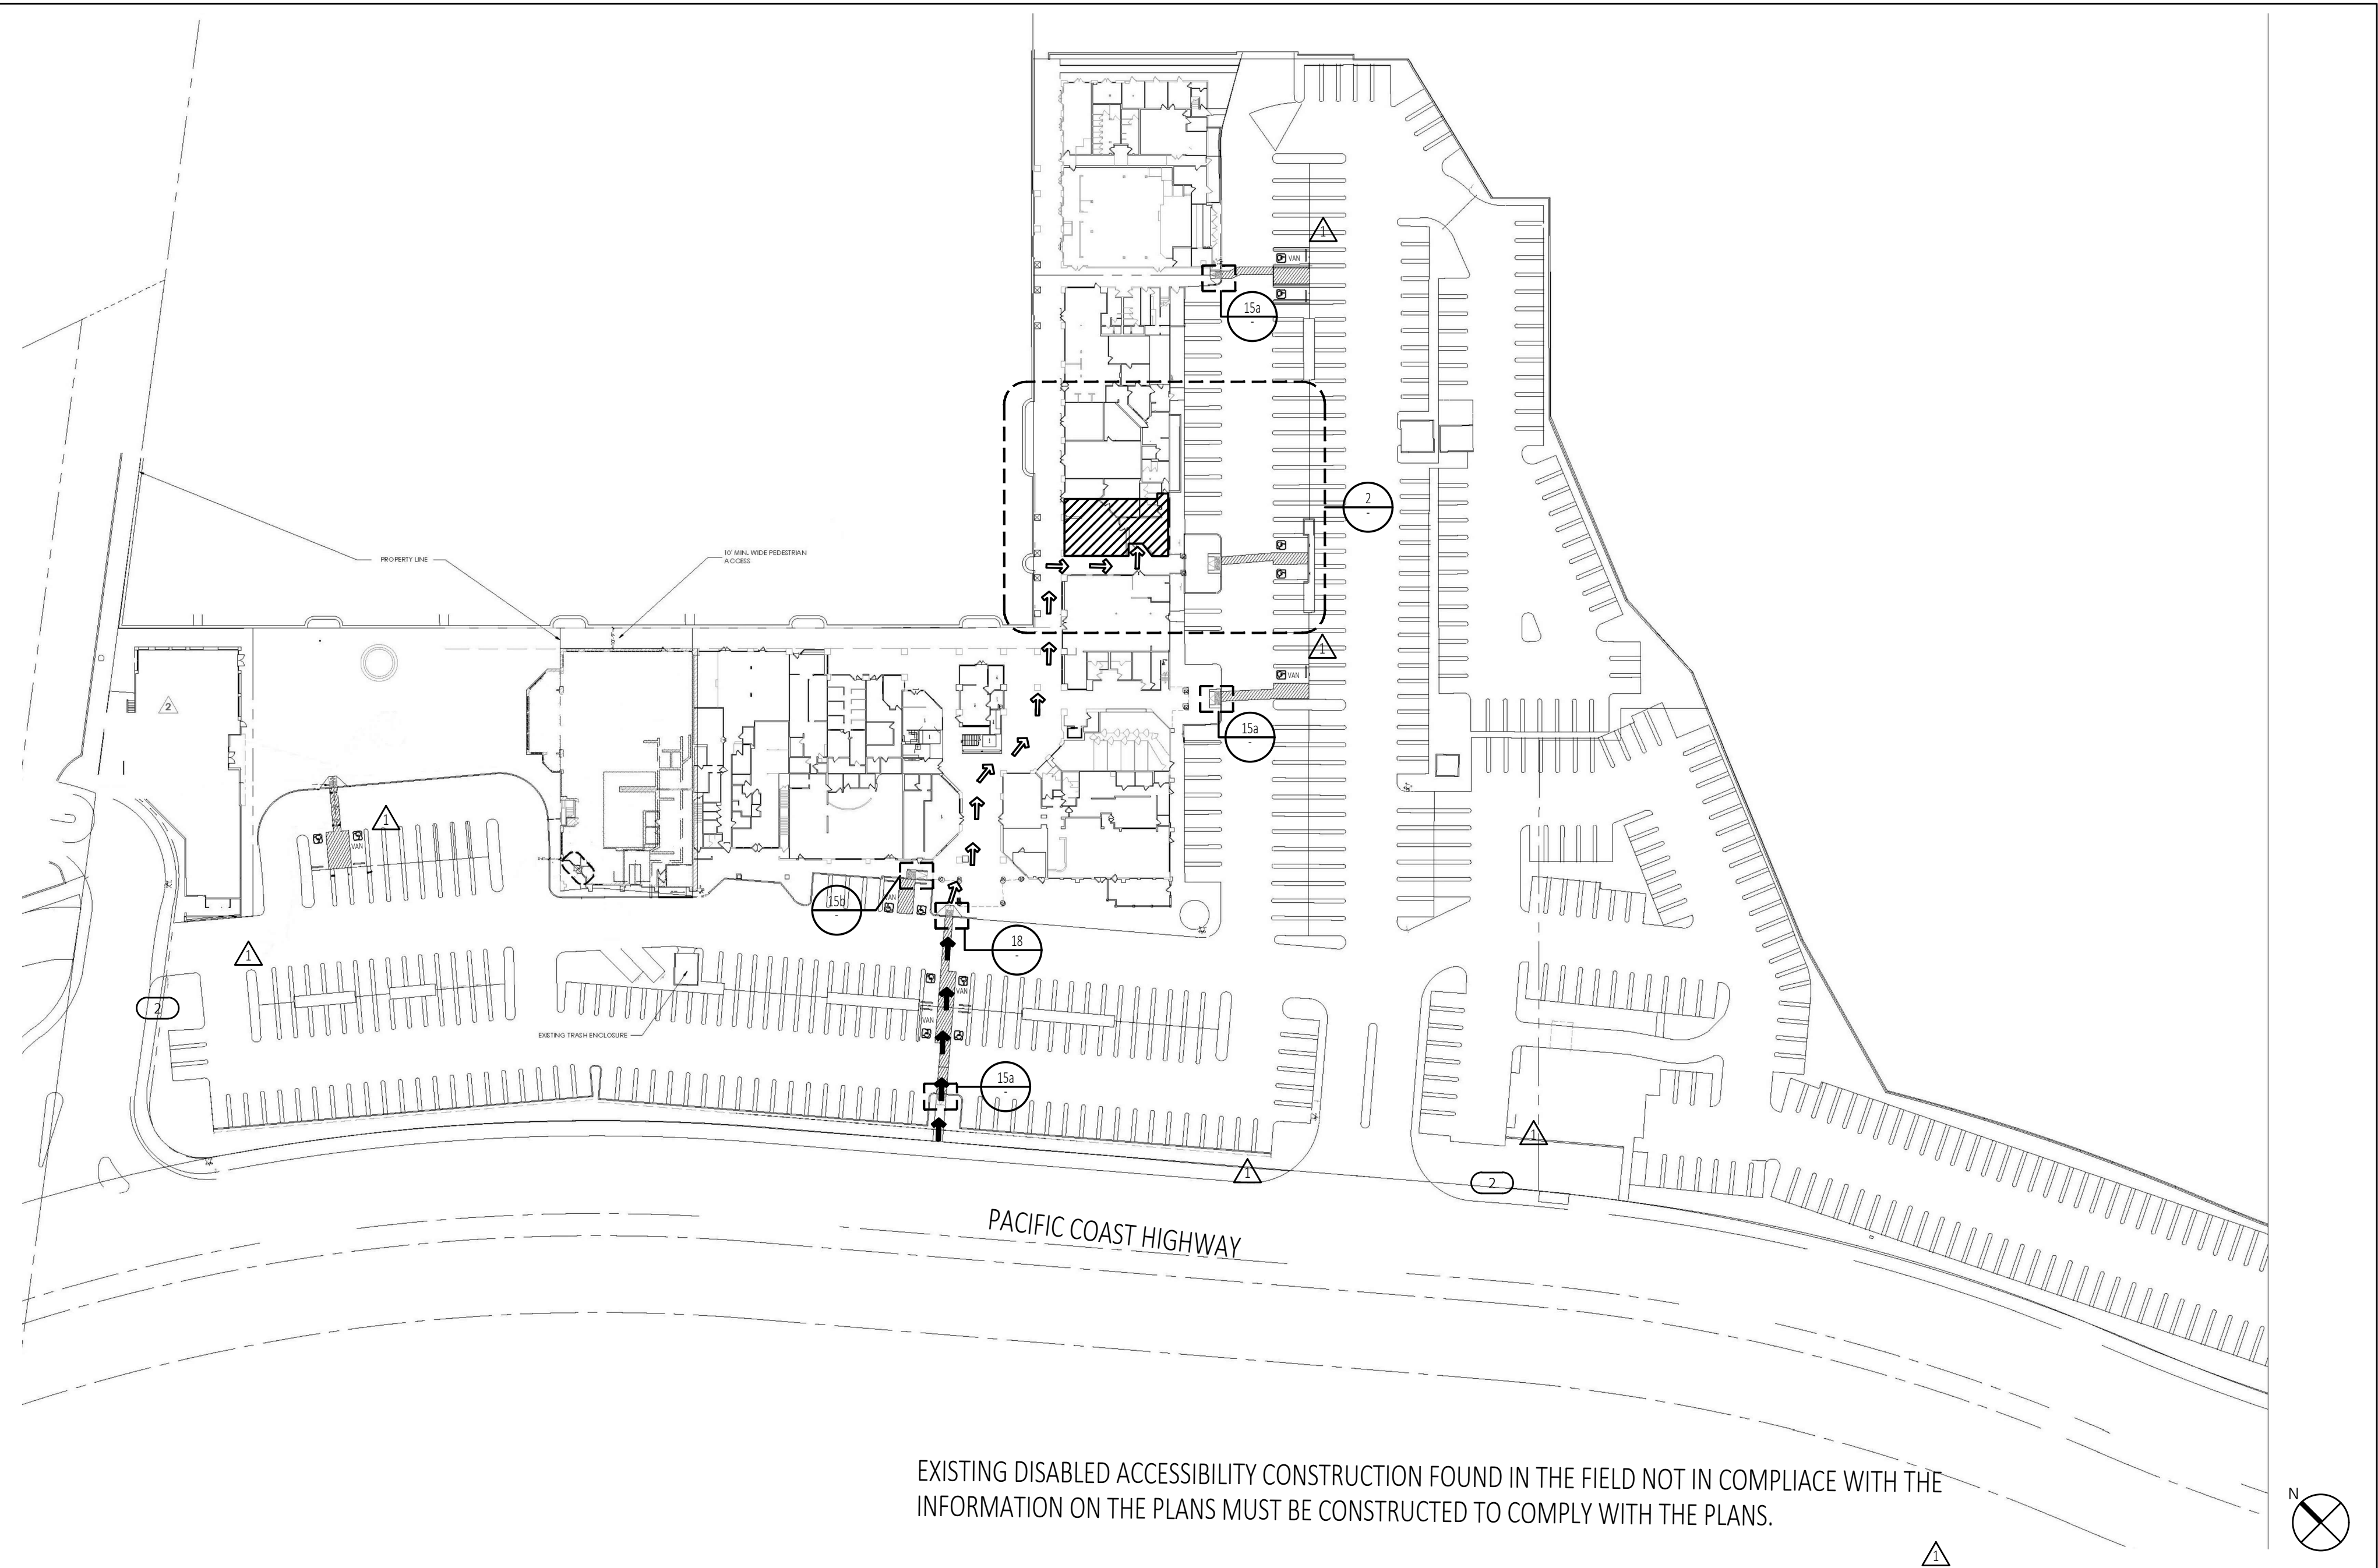


OVERALL SITE PLAN

SCALE: N.T.S.

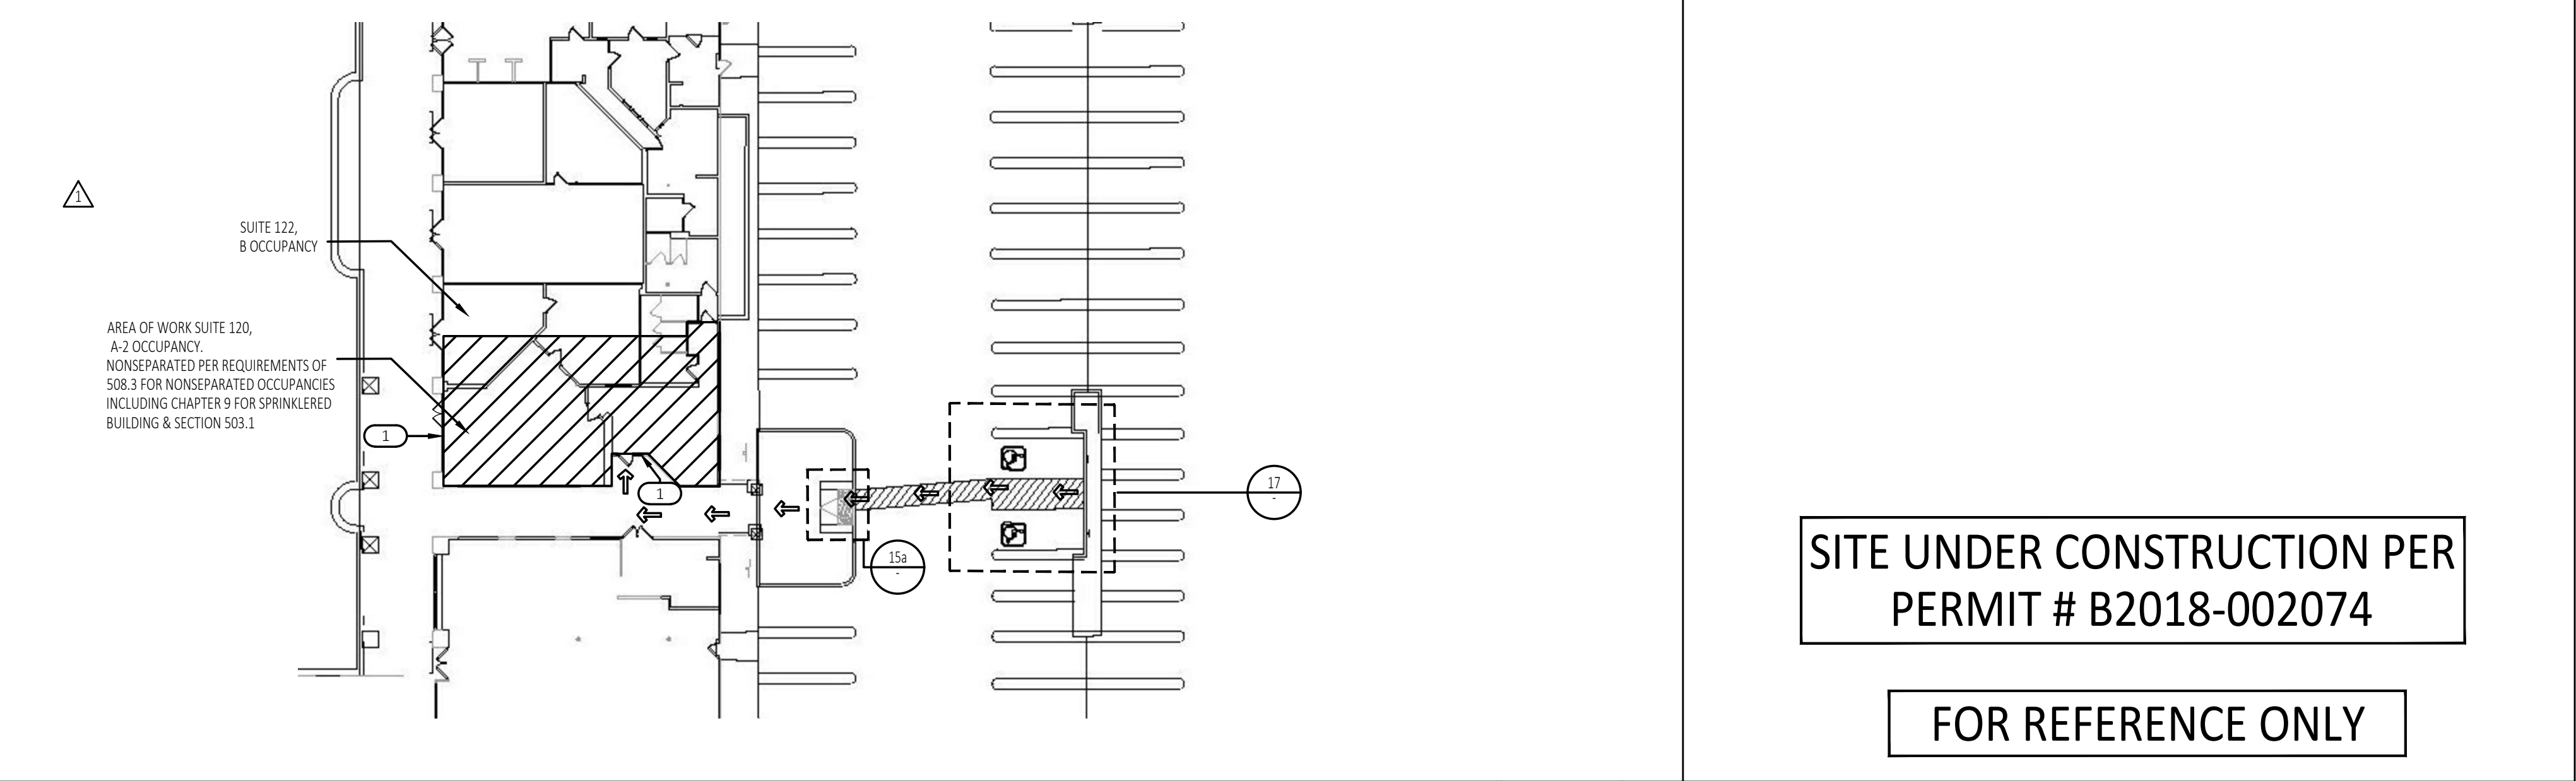

SITE UNDER CONSTRUCTION PER PERMIT # B2018-002074

FOR REFERENCE ONLY

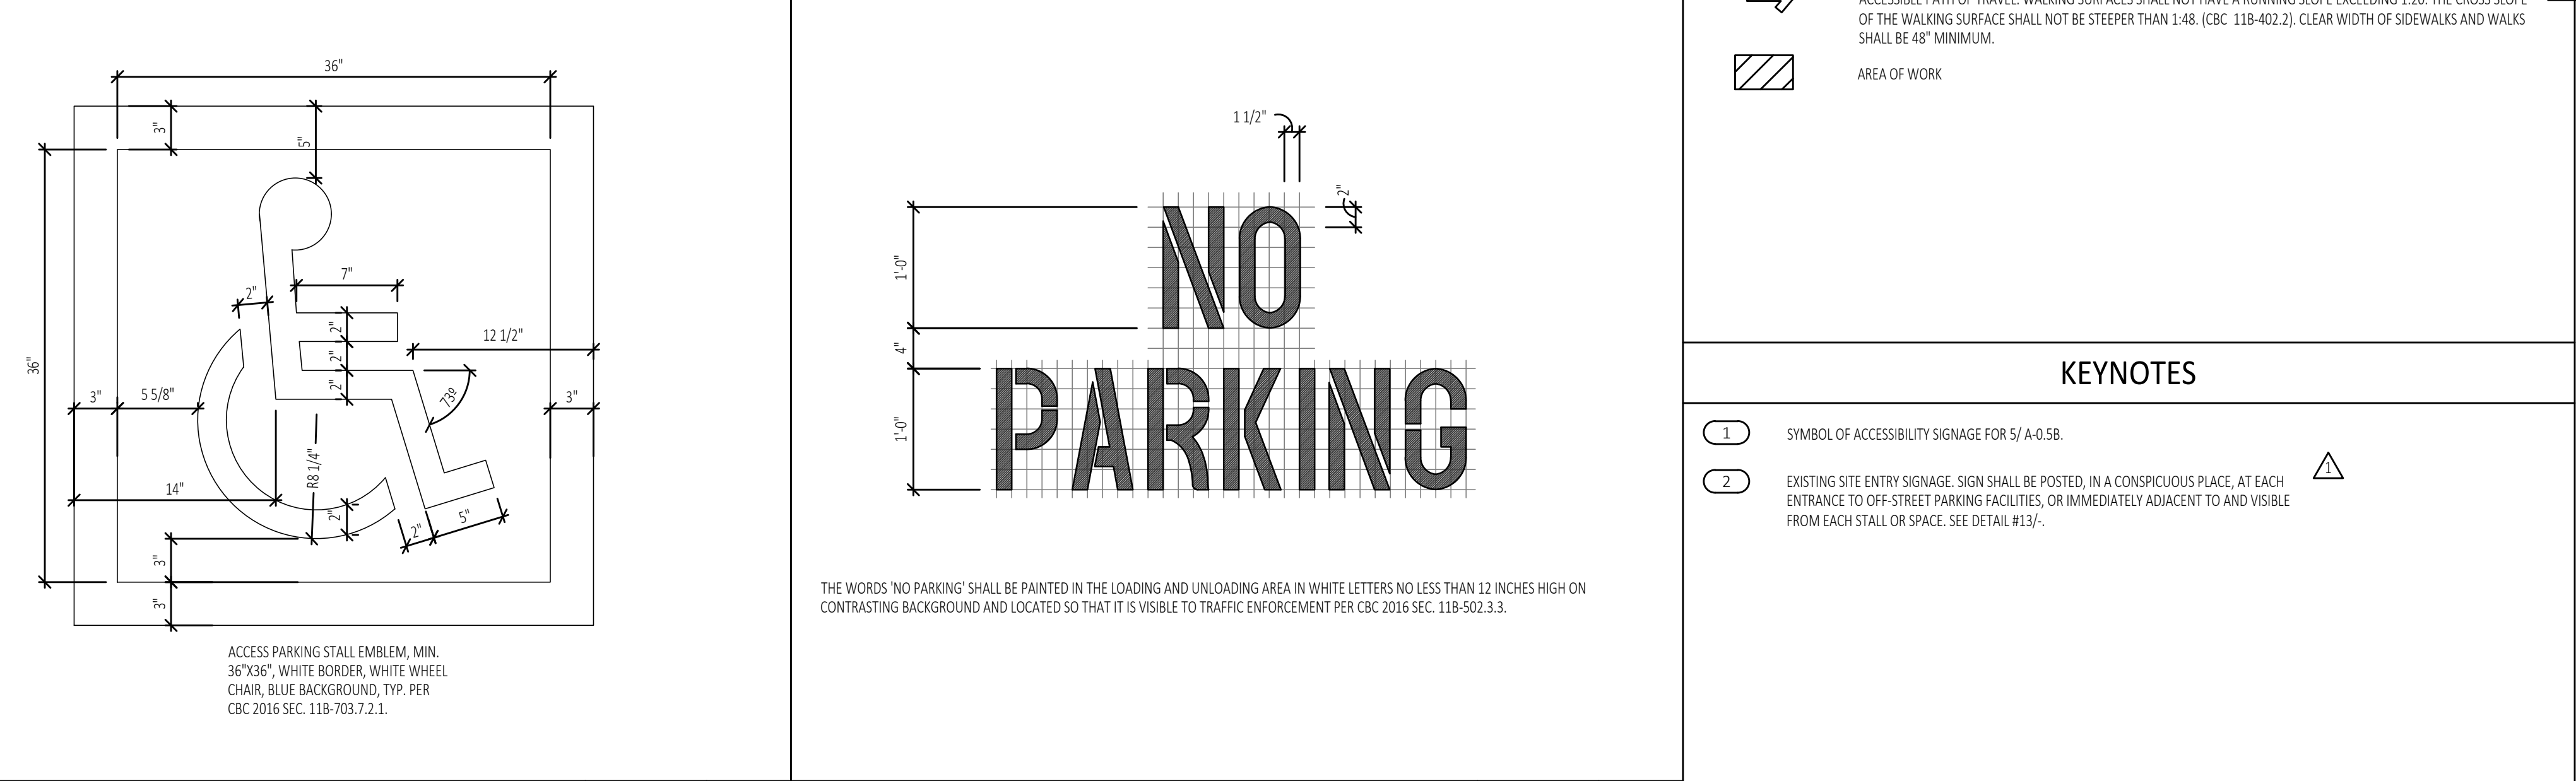

'NO PARKING' PAVEMENT MARKING

SCALE: 1/2" = 1'-0"

PROJECT: HIMALAYAN GRILL

SUITE 120
16400 PACIFIC COAST HWY
HUNTINGTON BEACH, CA 92649

saa
interiors + architecture
CULVER CITY, CA • IRVINE, CA • LOS ANGELES, CA
SAN FRANCISCO, CA • ISELIN, NJ • NEW YORK, NY
6083 Bristol Parkway
Culver City, CA 90230 T 310.553.3252
18600 MacArthur Blvd., Suite 100 T 949.724.8958
515 South Flower St., Suite 1200 T 213.929.1400
Los Angeles, CA 90071
535 Mission St., Suite 2027 T 415.390.6793
San Francisco, CA 94105
485C US Route 1 South, Suite 105 T 848.200.1200
Iselin, NJ 08830
713 3rd Ave., 6th Floor T 917.512.6688
New York, NY 10017
www.saaia.com

STAMP AND SIGNATURE:

CONSULTANTS:


DRAWINGS ISSUE		
DATE	DESCRIPTION	DELTA
11/07/19	ISSUE FOR ENGINEERING	
11/25/19	ISSUE FOR PLAN CHECK	
01/21/20	BULLETIN 1 - PLAN CHECK CORRECTIONS & TENANT REVISIONS	△
02/10/20	BULLETIN 2 - PLAN CHECK CORRECTIONS	△
05/07/21	REVISION TO PERMIT	△
05/11/21	PLAN CHECK CORRECTIONS	△

DATE: 10/31/19
DRAWN: RW
REVIEWED: MP
PROJECT NO: 626085.01
SCALE: AS NOTED
SHEET TITLE:

SITE PLAN AND ACCESSIBLE PATH OF TRAVEL

SHEET NO:

A-0.5A

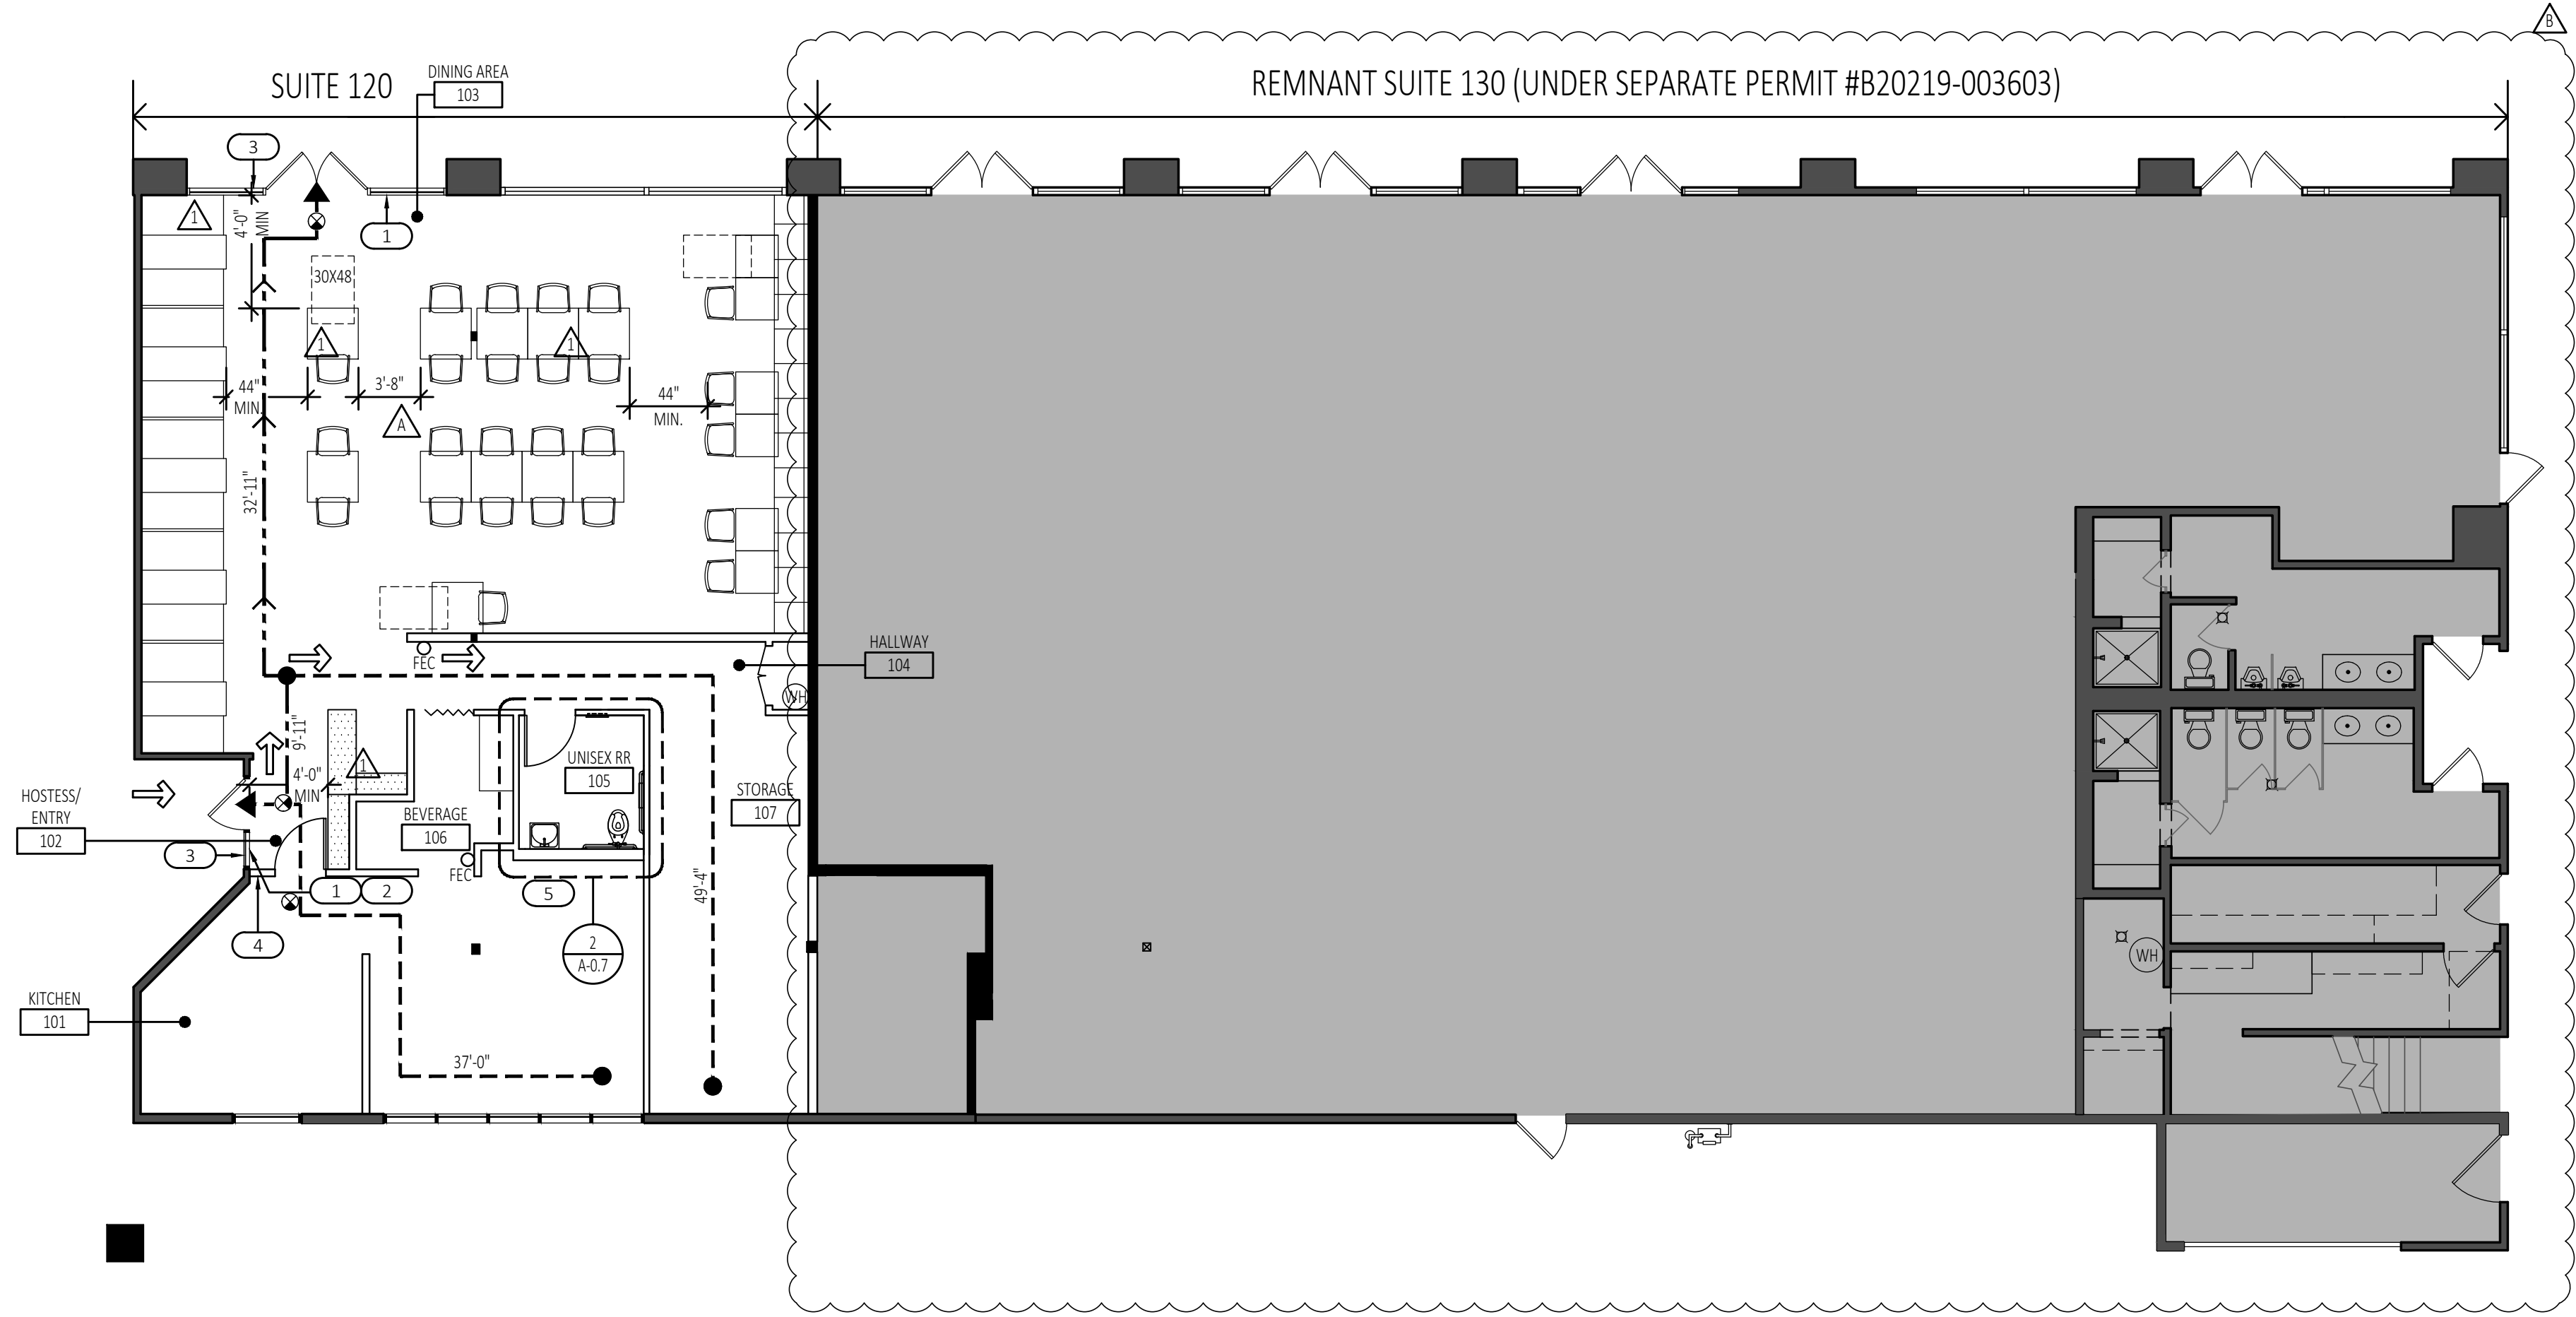

NOTE: COMMON AREA RESTROOMS MANAGED BY BUILDING OWNER ARE LOCATED ON PREMISES WITHIN 200' OF SUITE.

EXIT ANALYSIS - SUITE 120			
USE	SQUARE FOOTAGE	LOAD FACTOR	OCCUPANTS LOAD
DINING AREA- BOOTH SEATING ASSEMBLY UNCONCENTRATED	274 888	1 PERSON/24 INCHES 15 NET	26 59
KITCHEN/BEVERAGE	470	200 GROSS	3
HOSTESS/ENTRY	71	5 NET	15
HALLWAY	96	100	1
STORAGE	193	300	1
UNSEX RR	58	-	-

OCCUPANT CALCULATION - SUITE 120	
MAXIMUM TOTAL # OF OCCUPANTS	105
TOTAL OCCUPANT SQUARE FOOTAGE	±2,050
# OF EXITS REQUIRED FOR TABLE 1004.1.2 & 1002.2	2
# OF EXITS FOR SUITE	2

EXIT ANALYSIS - REMNANT SUITE 122			
USE	SQUARE FOOTAGE	LOAD FACTOR	OCCUPANTS LOAD
OFFICE	1,221	100	12

OCCUPANT CALCULATION - REMNANT SUITE 122	
MAXIMUM TOTAL # OF OCCUPANTS	12
TOTAL OCCUPANT SQUARE FOOTAGE	±1,221
# OF EXITS REQUIRED FOR TABLE 1004.1.2 & 1002.2	1
# OF EXITS FOR SUITE	1

PROJECT:
HIMALAYAN GRILL

SUITE 120
16400 PACIFIC COAST HWY
HUNTINGTON BEACH, CA 92649

saa
interiors + architecture
CULVER CITY, CA • IRVINE, CA • LOS ANGELES, CA
SAN FRANCISCO, CA • ISELIN, NJ • NEW YORK, NY

6083 Bristol Parkway
Culver City, CA 90030
T 310.553.3252

18600 MacArthur Blvd., Suite 100
Irvine, CA 92612
T 949.724.8958

515 South Flower St., Suite 1200
Los Angeles, CA 90071
T 213.929.1400

535 Mission St., Suite 2027
San Francisco, CA 94105
T 415.390.6793

485C US Route 1 South, Suite 105
Iselin, NJ 08830
T 848.200.1200

711 3rd Ave., 6th Floor
New York, NY 10017
T 917.512.6688

www.saaia.com

STAMP AND SIGNATURE:

CONSULTANTS:

DRAWINGS ISSUE		
DATE	DESCRIPTION	DELTA
11/07/19	ISSUE FOR ENGINEERING	
11/25/19	ISSUE FOR PLAN CHECK	
01/21/20	BULLETIN 1 - PLAN CHECK CORRECTIONS & TENANT REVISIONS	△
02/10/20	BULLETIN 2 - PLAN CHECK CORRECTIONS	△
05/07/21	REVISION TO PERMIT	△
06/11/21	PLAN CHECK CORRECTIONS	△

EXIT ANALYSIS / COMMON PATH OF EGRESS DISTANCE / MAXIMUM TRAVEL DISTANCE / TACTILE EXIT SIGN LOCATIONS

SCALE:
1/8"=1'-0"

3

NOTE: ALL SIGNAGE SHALL COMPLY WITH 2016 CBC 11B-703. REFER TO SHEET A-0.6 FOR ADDITIONAL INFORMATION

SCALE:
NTS

5

TACTILE EXIT SIGN

PERMANENT SIGNAGE TO BE INSTALLED ON THE WALL ADJACENT TO THE LATCH SIDE OF THE DOOR AT 48" ± F.F. MOUNTED LOCATION MUST ALLOW A PERSON TO APPROACH WITHOUT ENCOUNTERING PROTRUDING OBJECTS OR STANDING WITHIN SWING PATH OF THE DOOR [11B-307 (PROTRUDING OBJECTS); SEC. 1013.4 AND 11B-703 (TACTILE EXIT SIGNAGE)]

LETTERS & NUMBERS SHALL BE RAISED 1/32", UPPER CASE, SANS SERIF TYPE AND SHALL BE ACCOMPANIED WITH GRADE II BRAILLE BASED CHARACTERS. SHALL BE AT LEAST 8" HIGH, BUT NO HIGHER THAN 2" CHARACTERS AND BRAILLE SHALL BE IN HORIZONTAL FORMAT AND WITH BRAILLE PLACED 7" MIN AND 8" MAX DIRECTLY BELOW THE TACTILE CHARACTERS, FLUSH LEFT OR CENTERED.

NOTES

1. "STARS" W/ RAISED CHARACTERS AND BRAILLE SHALL BE LOCATED 48" MINIMUM ABOVE FINISH FLOOR OR GROUND SURFACE, MEASURED FROM THE BASELINE OF THE LOWEST LINE OF BRAILLE & 60" MAXIMUM ABOVE FINISH FLOOR OR GROUND SURFACE, MEASURED FROM THE BASELINE OF THE HIGHEST LINE OF RAISED CHARACTERS. MOUNTING LOCATION SHALL BE BEYOND THE ARC OF THE DOOR SWING BETWEEN THE CLOSED POSITION AND THE 45 DEGREE OPEN POSITION.

2. RAISED CHARACTERS ON SIGNS SHALL BE SELECTED FROM FONTS WHERE THE WIDTH OF THE UPPERCASE LETTER "O" IS 60% MINIMUM AND 110% MAXIMUM OF THE HEIGHT OF THE UPPERCASE "I". STROKE THICKNESS OF THE UPPERCASE "I" SHALL BE 15% MAXIMUM OF THE HEIGHT OF THE CHARACTER.

LITERARY BRAILLE STANDARD DIMENSIONS

DOT DIAMETER - .059"

INTER-DOT SPACING - .290"

HORIZONTAL SEPARATION BETWEEN CELLS - .241"

VERTICAL SEPARATION BETWEEN CELLS - .395"

TACTILE EXIT SIGNS SHALL BE REQUIRED AT THE FOLLOWING LOCATIONS:

1. A TACTILE EXIT SIGN WITH THE WORD "EXIT", SHALL IDENTIFY EACH GRADE LEVEL EXTERIOR EXIT DOOR.

2. A TACTILE EXIT SIGN WITH THE WORDS "EXIT ROUTE" SHALL IDENTIFY EACH EXIT ACCESS DOOR FROM AN INTERIOR ROOM OR AREA TO A CORRIDOR OR HALLWAY THAT IS REQUIRED TO HAVE A VISUAL EXIT SIGN.

KEYNOTES

1. TACTILE EXIT SIGNAGE. SEE DETAIL #1.

2. PROVIDE NEW OCCUPANT LOAD SIGNAGE PER SECTION 1004.3 SIGN WALL SHALL BE POSTED IN A CONSPICUOUS PLACE NEAR THE MAIN EXIT OR EXIT ACCESS DOORWAY FROM THE ROOM. REFER TO APPLICABLE ASSEMBLY OCCUPANT LOAD CALCULATION PER EXIT ANALYSIS TABLE ON THIS SHEET.

3. INTERNATIONAL SYMBOL OF ACCESSIBILITY LOCATED ON 1st FLOOR. SEE DETAIL #5.

4. TACTILE EXIT ROUTE SIGNAGE. SEE DETAIL #2.

5. NEW ANSUL FIRE PROTECTION SYSTEM TO BE PROVIDED PER SHEET K-01.

LEGEND

AREA NOT IN CONTRACT (N.I.C.).

EXISTING CONSTRUCTION TO REMAIN.

NEW CONSTRUCTION, TYPICAL PARTITION UNLESS OTHERWISE NOTED.

COMMON PATH OF EGRESS

MAXIMUM PATH OF TRAVEL



ACCESSIBLE PATH OF TRAVEL

WALL MOUNTED FIRE EXTINGUISHER ON WALL HANGER BRACKET. TYPE "K" AT KITCHEN, TYPE "ABC" AT DINING AREA.




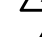
EXIT ROUTES AND TACTILE SIGNAGE

SHEET NO:

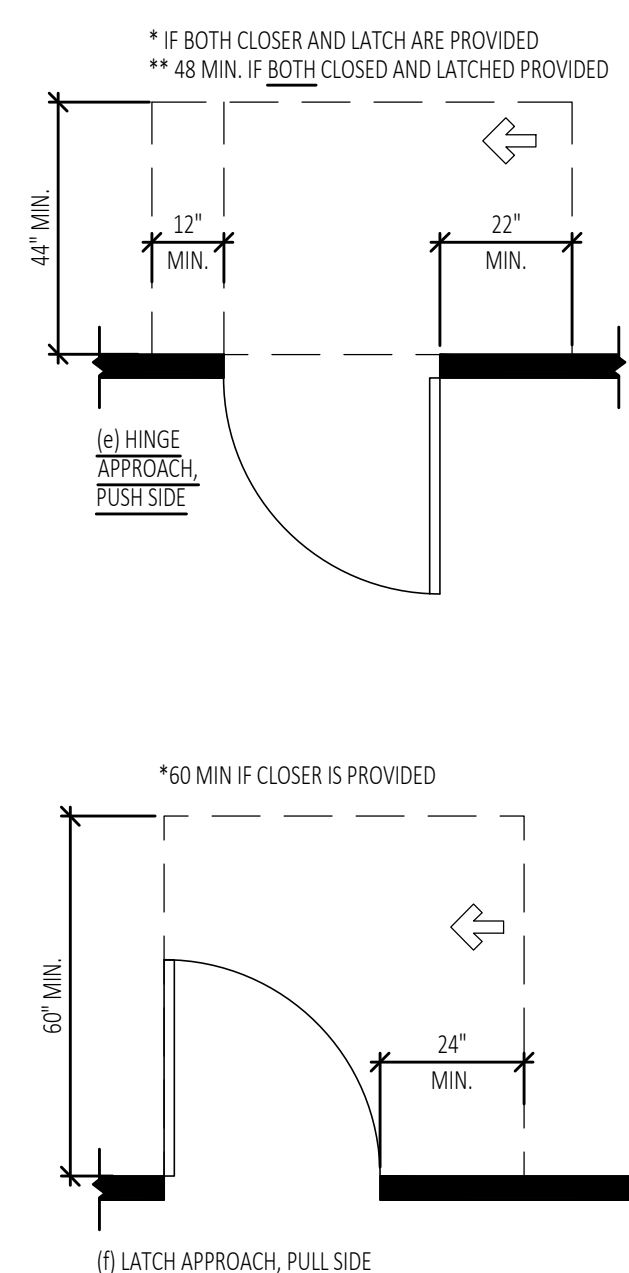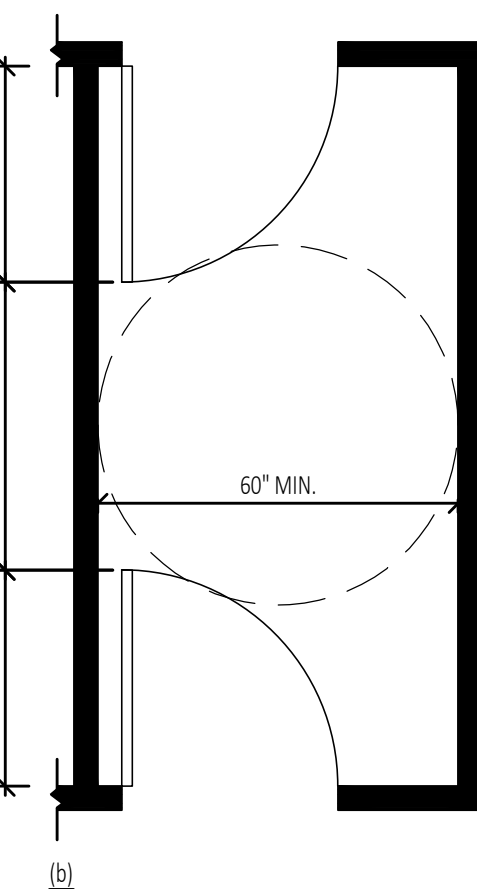A-0.5B



NOT SUBJECT TO REVIEW, FOR REFERENCE ONLY



DRAWINGS ISSUE		
DATE	DESCRIPTION	DELTA
11/07/19	ISSUE FOR ENGINEERING	
11/26/19	ISSUE FOR PLAN CHECK	
01/21/20	BULLETIN 1 - PLAN CHECK CORRECTIONS & TENANT REVISIONS	
02/10/20	BULLETIN 2 - PLAN CHECK CORRECTIONS	
05/07/21	REVISION TO PERMIT	
06/11/21	PLAN CHECK CORRECTIONS	





DATE:	10/31/15
DRAWN:	RW
REVIEWED:	MR
PROJECT NO:	626085.0
SCALE:	AS NOTED
SHEET TITLE:	


BASE BUILDING ACCESSIBILITY

SHEET NO _____

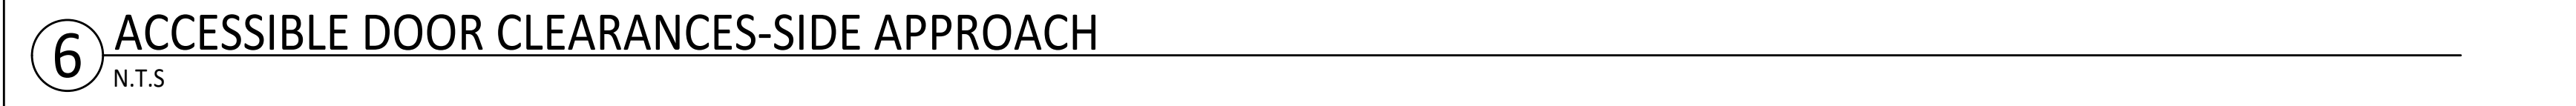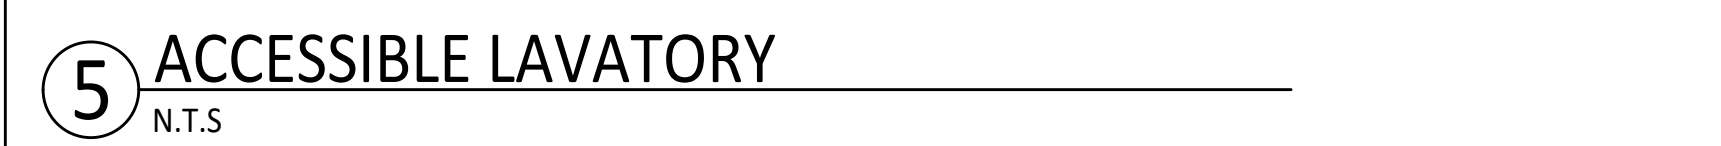A-0.6A

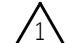

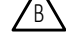
DRAWINGS ISSUE		
DATE	DESCRIPTION	DELTA
11/07/19	ISSUE FOR ENGINEERING	
11/25/19	ISSUE FOR PLAN CHECK	
01/21/20	BULLETIN 1 - PLAN CHECK CORRECTIONS & TENANT REVISIONS	
02/10/20	BULLETIN 2 - PLAN CHECK CORRECTIONS	
05/07/21	REVISION TO PERMIT	
06/11/21	PLAN CHECK CORRECTIONS	

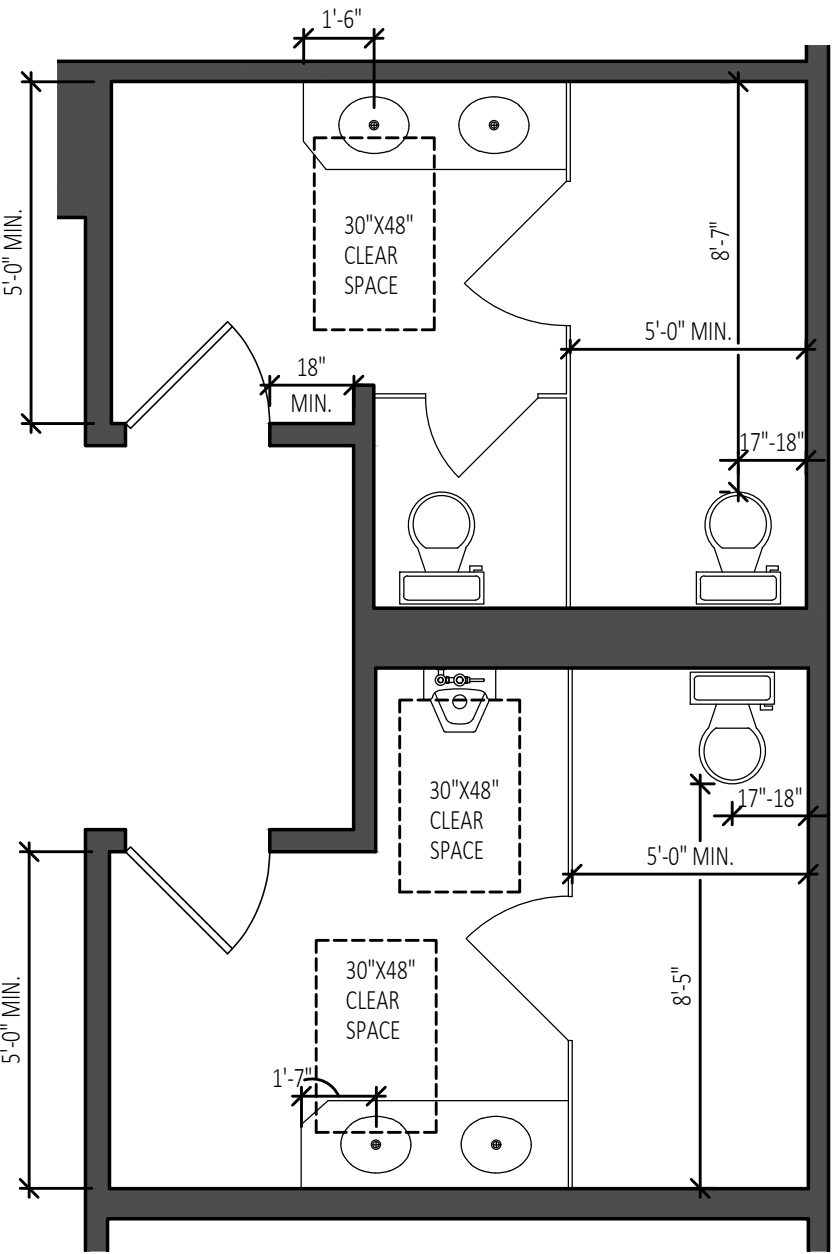

NOTE: FOR REFERENCE ONLY. COMMON AREA RESTROOMS MANAGED BY BUILDING OWNER ARE LOCATED ON PREMISES WITHIN 200' OF SUITE.

EXISTING COMMON AREA RESTROOM PLAN

SCALE: 1/4" = 1'-0"
3

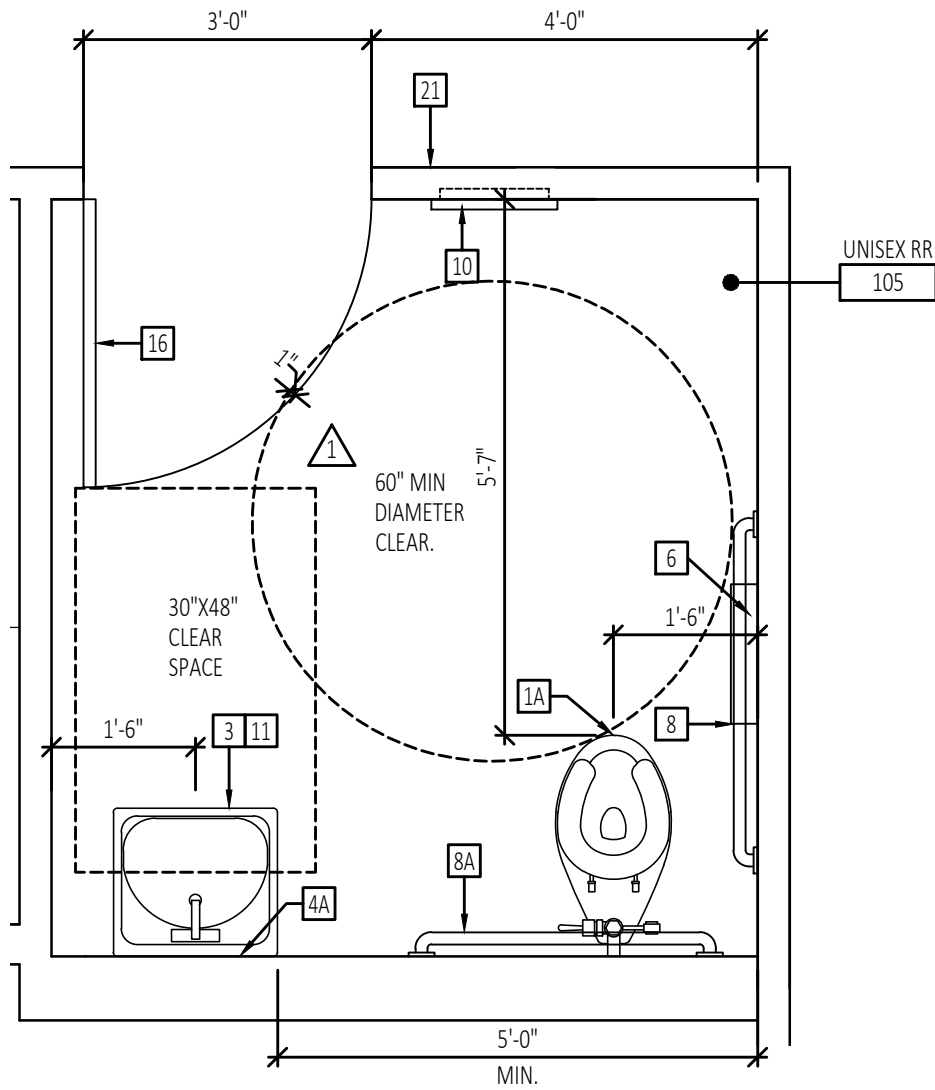

PLUMBING ANALYSIS

AREA:
DINING AREA/HOSTESS/HALLWAY: 1,247 SF
KITCHEN/BEVERAGE: 750 SF

PLUMBING OCCUPANT LOAD:
1,247SF/20 = 41.5 OCCUPANTS
750SF/200 = 3.75 OCCUPANTS
TOTAL = 45 OCCUPANTS

* PER 2016 PLUMBING CODE SECTION 422.2 EXCEPTION #3,
ONE TOILET FACILITY DESIGNED FOR USE BY NO MORE THAN ONE
PERSON AT A TIME, SHALL BE PERMITTED FOR USE BY BOTH SEXES.



HEALTH DEPARTMENT NOTES

26. RESTROOMS
- A. TOILET FACILITIES ARE REQUIRED WITHIN EACH FOOD FACILITY FOR USE BY HT EMPLOYEES.
- B. IN FOOD FACILITIES CONSTRUCTED ON OR AFTER JANUARY 1, 2004, AT LEAST ONE PUBLIC ACCESSIBLE RESTROOM MUST BE PROVIDED. SHALL BE LOCATED AT ENTRANCES TO UNISEX TOILET AND BATHING FACILITIES. PATRONS MAY NOT ACCESS THE RESTROOM BY PASSING THROUGH FOOD PREPARATION, FOOD STORAGE OR UTENSIL WASHING AREAS.
- C. HAND WASHING SINKS SHALL BE PROVIDED WITHIN OR ADJACENT TO EACH TOILET ROOM. THE SINK SHALL PROVIDE WATER OF AT LEAST 100° FAHRENHEIT THROUGHOUT A MIXING VALVE OR COMBINATION FAUCET. SOAP AND SANITARY TOWELS IN SINGLE-SERVICE DISPENSERS SHALL BE PROVIDED AT THE HAND WASHING SINK. HEATED-AIR HAND DRYING DEVICES MAY BE USED IN LIEU OF SANITARY TOWELS.
- D. TOILET TISSUE SHALL BE PROVIDED IN A PERMANENTLY INSTALLED DISPENSER AT EACH TOILET.
- E. THE RESTROOMS SHALL BE PROVIDED WITH WELL-FITTING, SELF-CLOSING DOORS.
- F. ALL TOILET ROOMS SHALL BE PROVIDED WITH VENTILATION. IF ADEQUATE VENTILATION CANNOT BE PROVIDED BY AN OPERABLE, SCREENED WINDOW, MECHANICAL VENTILATION WILL BE REQUIRED.
- G. COMMON RESTROOMS MUST BE WITHIN 200 FT. AND MAY BE PERMITTED WITH THE PRESENCE OF ON-SITE PROPERTY MANAGEMENT.

ENLARGED RESTROOM PLAN

SCALE: 1/2" = 1'-0"
2

SANITARY FACILITIES

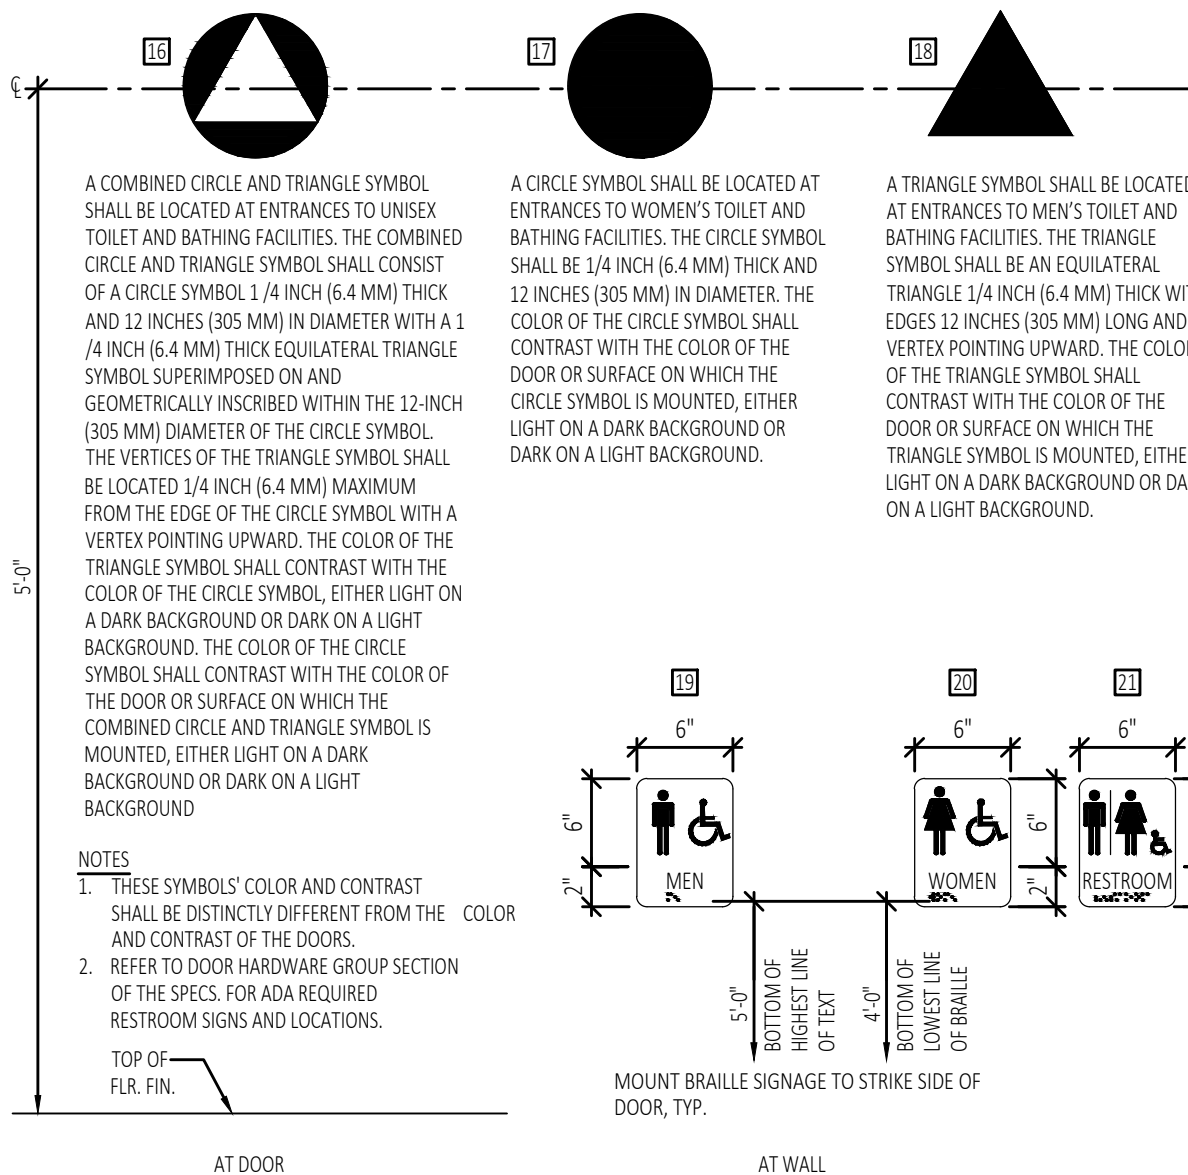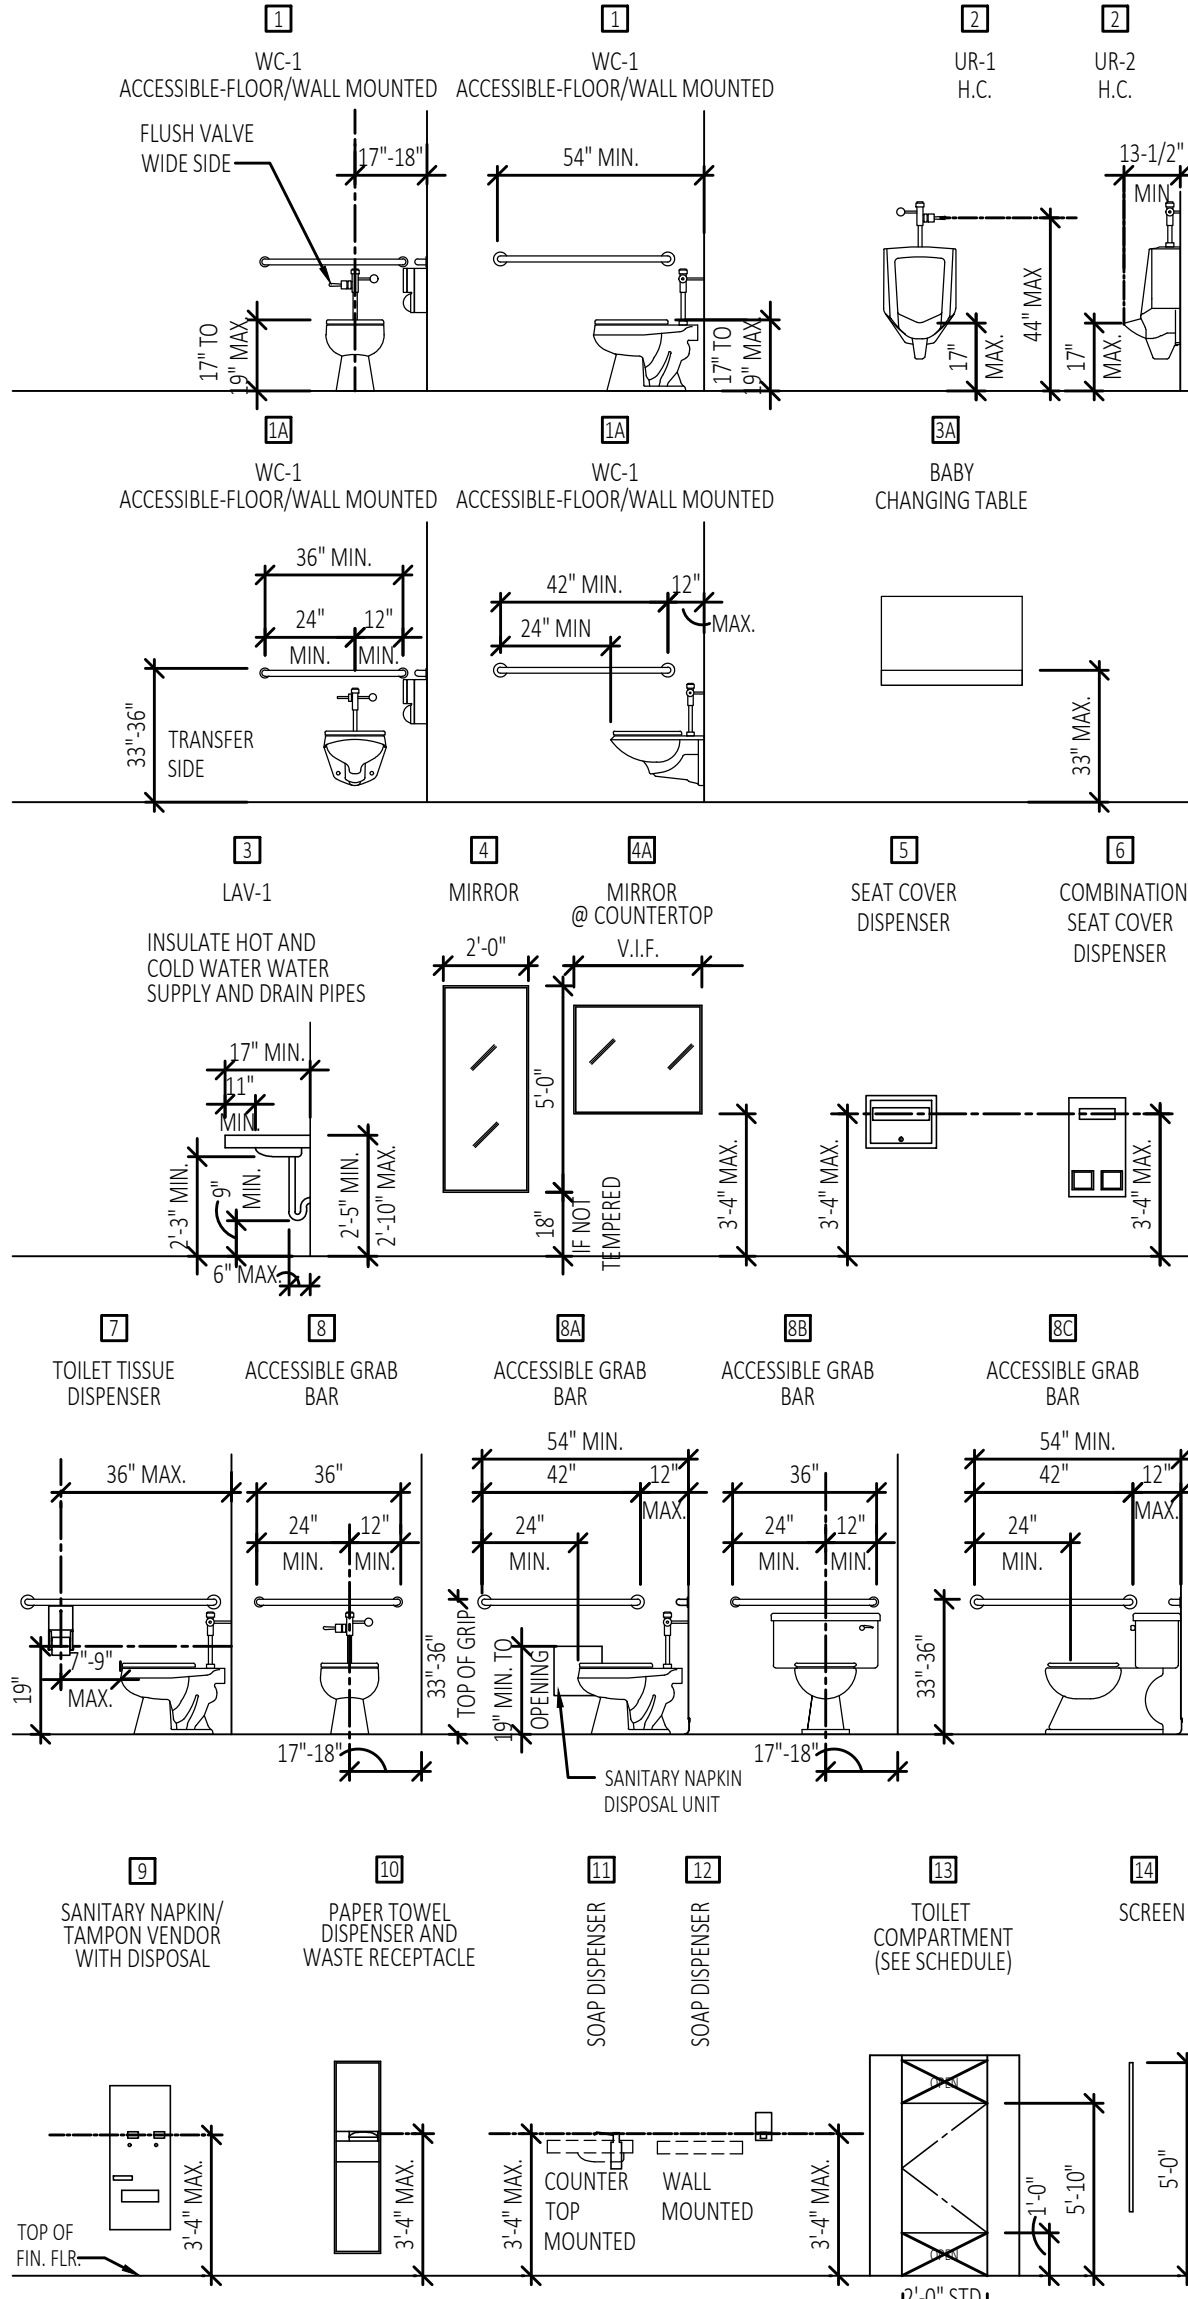

TYP. ACCESSORY MOUNTING DIMENSIONS

SCALE: NTS
1

FIXTURE AND ACCESSORY SCHEDULE

10 NEW DOOR MOUNTED ACCESSIBLE SIGNAGE FOR ALL GENDER RESTROOM SIZE: 12" CIRCLE COLOR: GREY	02 FLOOR MOUNTED ACCESSIBLE WATER CLOSET: MANUF.: AMERICAN STANDARD NAME: MAJESTIC FLOWWISE ELONGATED TOILET NUMBER: 3043.001 FINISH: WHITE SEAT: 5901.100 FLUSH VALVE: 1.28 GPF AUTOMATIC
08 NEW WALL MOUNTED ACCESSIBLE SIGNAGE FOR ALL GENDER RESTROOM: SIZE: 8" X 8" COLOR: GREY	01 ACCESSIBLE WALL MOUNTED SINK: MANUF.: AMERICAN STANDARD NAME: DECORUM NUMBER: 9024.011EC FINISH: WHITE SIZE: 20" X 18" FAUCET: AMERICAN STANDARD PARADIGM 702B HARDWIRED CONNECTION, POLISHED CHROME FINISH.
	04 LIGHTED VANITY MIRROR: MANUF.: PARIS MIRROR NAME: GALAXY II SIZE: 24"X36"
	01 RECESSED SEAT COVER DISPENSER, SANITARY NAPKIN DISPOSAL & TOILET TISSUE DISPENSER: MANUF.: BOBICK CLASSIC SERIES NUMBER: B-3574 FINISH: STAINLESS STEEL
	01 STAINLESS STEEL GRAB BAR WITH CONCEALED MOUNTING: MANUF.: BOBICK NUMBER: B-6800-48" FINISH: STAINLESS STEEL
	02 STAINLESS STEEL GRAB BAR WITH CONCEALED MOUNTING: MANUF.: BOBICK NUMBER: B-6800-36" FINISH: STAINLESS STEEL
	08 SEMI-RECESSED PAPER TOWEL DISPENSER / WASTE RECEPTACLE: MANUF.: GEORGIA-PACIFIC, HIGH CAPACITY TRASH RECEPTACLE FOR 66MOTION RECESSED AUTOMATED TOWEL DISPENSER NUMBER: 59491 / 59466 FINISH: STAINLESS STEEL R.D.: 16" WIDE x 54" HIGH x 4" MIN. DEPTH
	01 AUTOMATIC LAVATORY MOUNTED LIQUID SOAP DISPENSER: MANUF.: KOHLER NUMBER: K-1995-CP FINISH: POLISHED CHROME

PROJECT:
HIMALAYAN GRILL

SUITE 120
16400 PACIFIC COAST HWY
HUNTINGTON BEACH, CA 92649

saa
interiors + architecture
CULVER CITY, CA • IRVINE, CA • LOS ANGELES, CA
SAN FRANCISCO, CA • ISELIN, NJ • NEW YORK, NY

6083 Bristol Parkway
Culver City, CA 90030
T 310.553.3252

18600 MacArthur Blvd., Suite 100
Irvine, CA 92612
T 949.724.8958

515 South Flower St., Suite 1200
Los Angeles, CA 90071
T 213.929.1400

535 Mission St., Suite 2027
San Francisco, CA 94105
T 415.390.6793

485C US Route 1 South, Suite 105
Iselin, NJ 08830
T 848.200.1200

711 3rd Ave., 6th Floor
New York, NY 10017
T 917.512.6688

www.saaia.com
STAMP AND SIGNATURE:

CONSULTANTS:

DRAWINGS ISSUE

DATE	DESCRIPTION	DELTA
11/07/19	ISSUE FOR ENGINEERING	
11/25/19	ISSUE FOR PLAN CHECK	
01/21/20	BULLETIN 1 - PLAN CHECK CORRECTIONS & TENANT REVISIONS	△
02/10/20	BULLETIN 2 - PLAN CHECK CORRECTIONS	△
05/07/21	REVISION TO PERMIT	△
06/11/21	PLAN CHECK CORRECTIONS	△



DATE: 10/31/19
DRAWN: RW
REVIEWED: MP
PROJECT NO: 626085.01
SCALE: AS NOTED



SHEET TITLE:

BASE BUILDING RESTROOM
ACCESSIBILITY PLANS

SHEET NO:

A-0.7

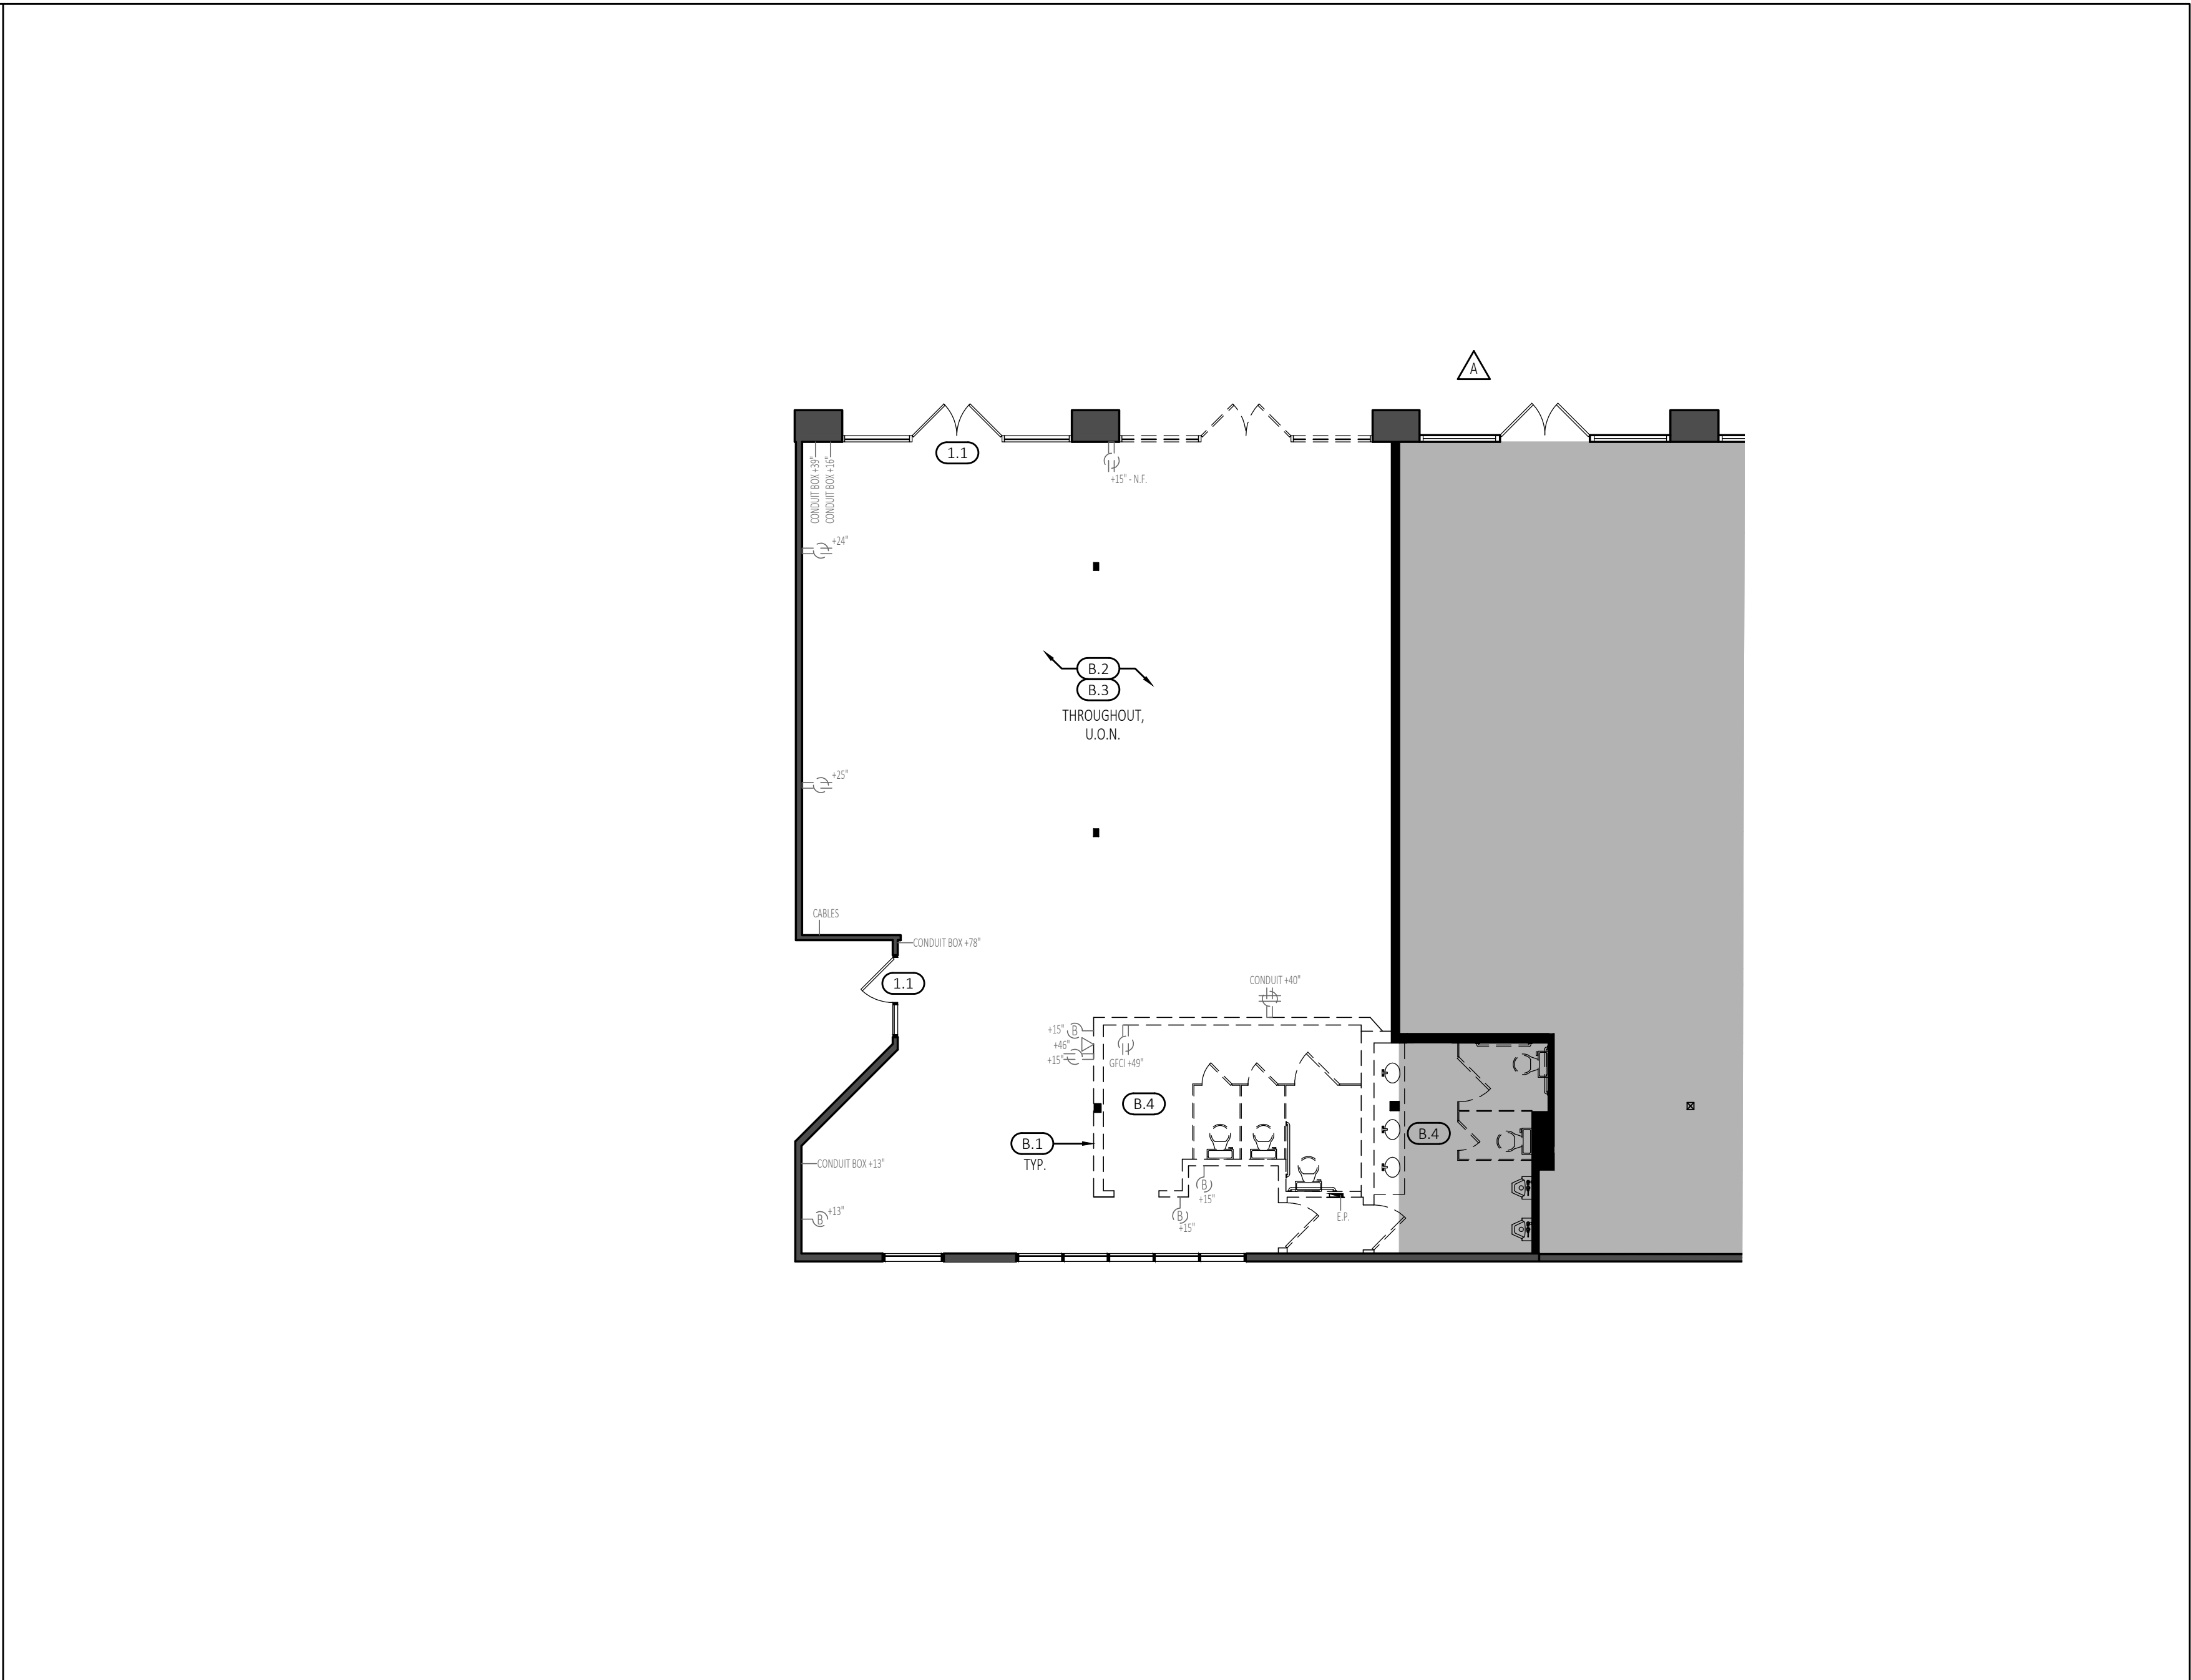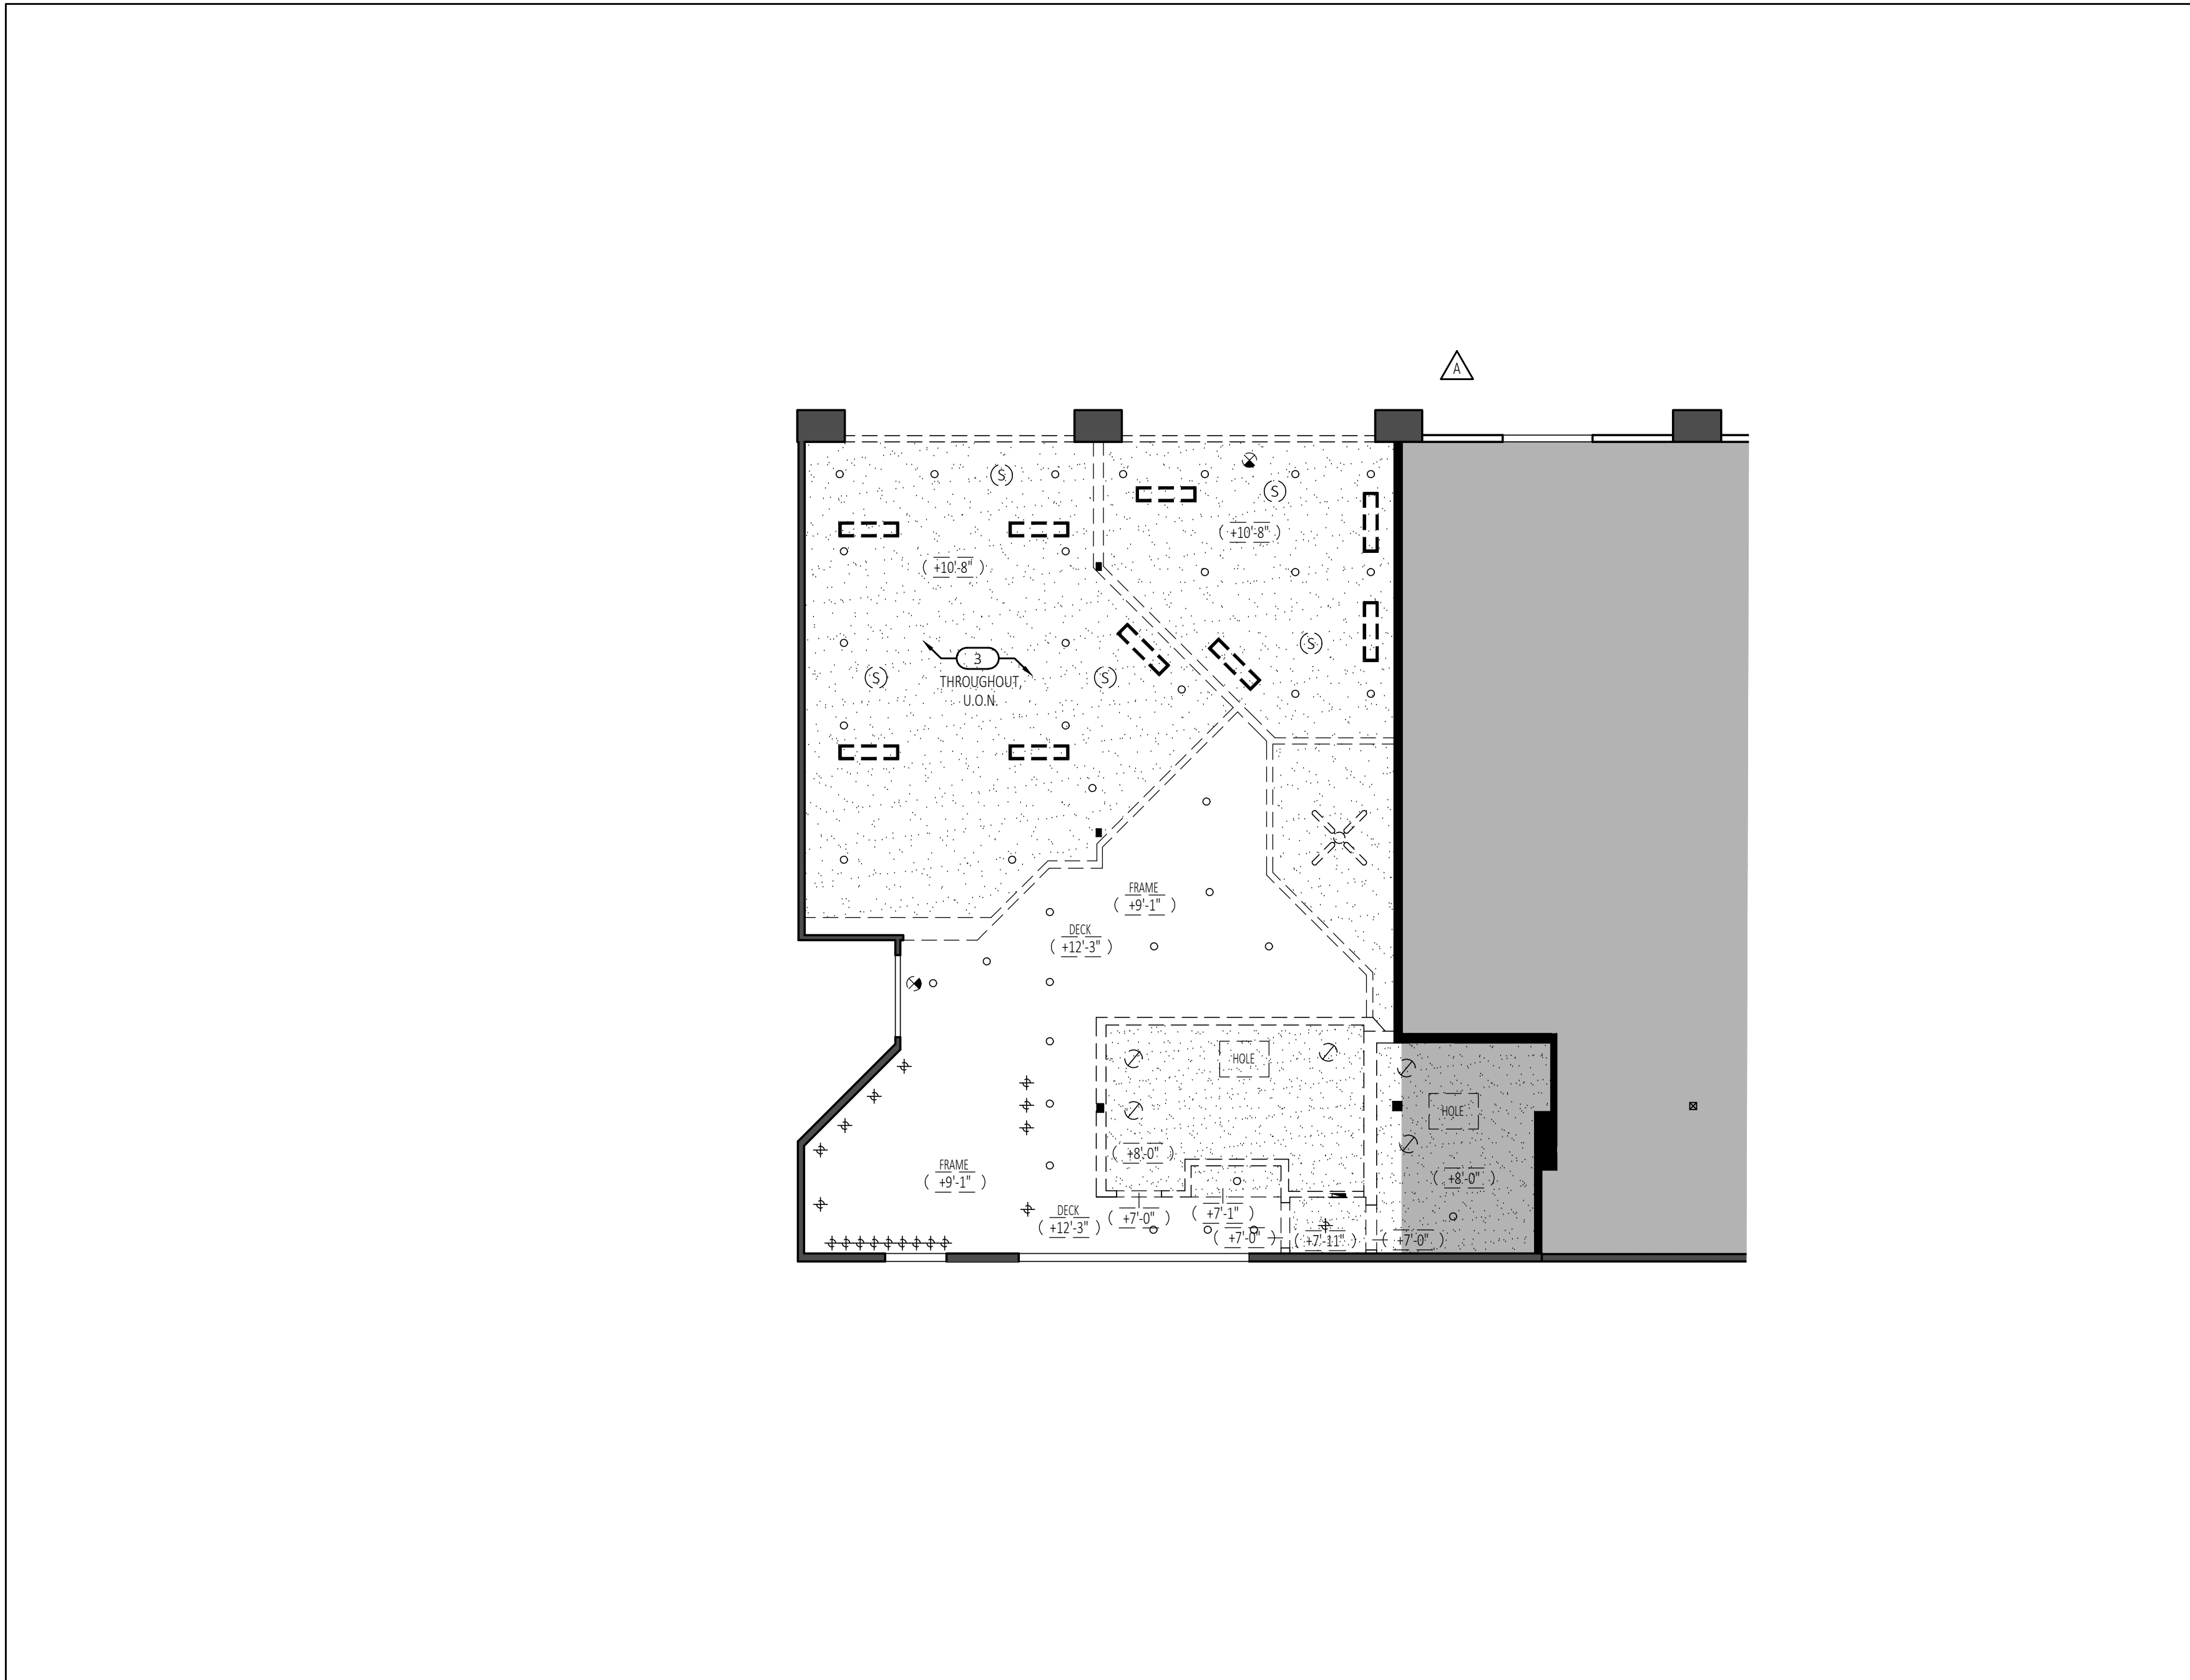

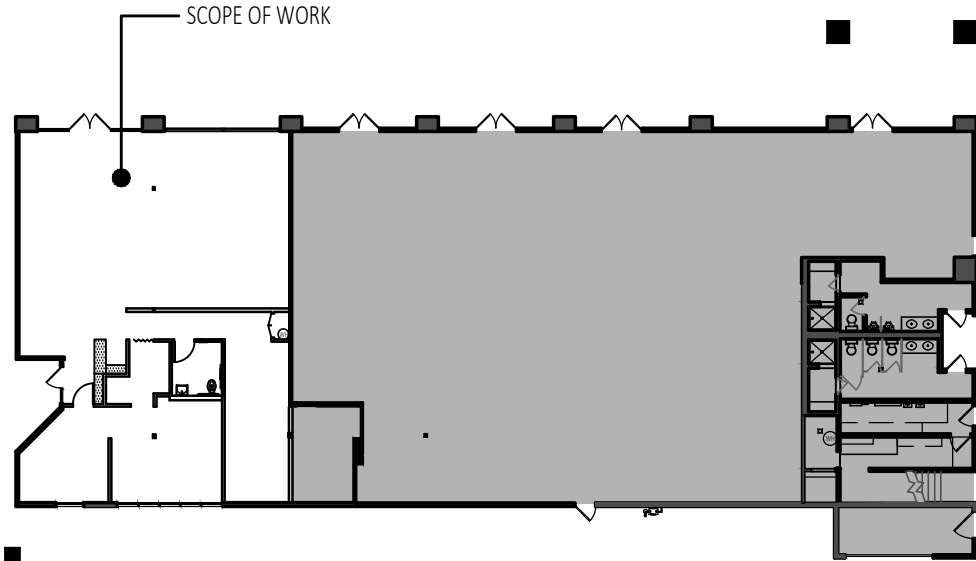DEMOLITION CEILING PLAN		SCALE: 1/8"=1'-0"	2	DEMOLITION PLAN		SCALE: 1/8"=1'-0"	1			
DEMOLITION CEILING KEYNOTES			DEMOLITION CEILING LEGEND		DEMOLITION KEYNOTES		DEMOLITION LEGEND			
<div><div>1</div><div>GENERAL CONTRACTOR TO REWORK HVAC SYSTEMS ALONG NEW DEMISING PARTITION TO PROVIDE SUITE SEPARATION AND ELIMINATE CROSS ZONING. NOT USED.</div></div> <div><div>2</div><div>GENERAL CONTRACTOR TO PROVIDE SEPARATION OF LIGHTING CONTROLS BETWEEN SUITES. NOT USED.</div></div> <div><div>3</div><div>REMOVE EXISTING UNUSED CEILING EQUIPMENT AND SUPPORTS THROUGHOUT. PREP EXISTING CEILING FOR NEW LAYOUT.</div></div>			<div><div></div><div>AREA NOT IN CONTRACT (N.I.C.)</div></div> <div><div></div><div>EXISTING PARTITION TO REMAIN.</div></div> <div><div>=====</div><div>EXISTING PARTITION TO BE DEMOLISHED AND REMOVED FROM SITE.</div></div> <div><div><div><div></div><div></div><div></div></div></div><div>EXISTING SOFFIT TO BE REMOVED.</div></div> <div><div><div><div></div><div></div><div></div></div></div><div>EXISTING LIGHT FIXTURE TO BE REMOVED.</div></div> <div><div><div><div></div><div></div><div></div></div></div><div>EXISTING DOWNLIGHT FIXTURE TO BE REMOVED.</div></div> <div><div><div><div></div><div></div><div></div></div></div><div>EXISTING LIGHT FIXTURE TO BE REMOVED.</div></div> <div><div><div><div></div><div></div><div></div></div></div><div>EXISTING LIGHT FIXTURE TO BE REMOVED.</div></div> <div><div><div><div></div><div></div><div></div></div></div><div>EXISTING CEILING MOUNTED EXIT SIGN TO BE REMOVED.</div></div> <div><div><div><div></div><div></div><div></div></div></div><div>EXISTING SPEAKER TO BE REMOVED.</div></div>		<div><div>1.</div><div>REFER TO SHEETS A-0.2 AND A-0.3 FOR TYPICAL SPECIFICATIONS. REFER TO SHEET A-0.1 FOR GENERAL DRAFTING STANDARDS AND ABBREVIATIONS USED. REFER TO SHEET A-0.2 FOR GENERAL NOTES. REFER TO SHEET A-0.6A AND A-0.6B FOR DISABLED ACCESS NOTES. REFER TO SHEET A-0.1 FOR FIRE AND SAFETY NOTES.</div></div> <div><div>2.</div><div>REFER TO SHEET A-0.2 FOR TYPICAL DEMOLITION NOTES AND PATCHING AND CLEANING NOTES.</div></div>		<div><div>1.1</div><div>VERIFY EXISTING DOORS AND HARDWARE ARE IN GOOD WORKING ORDER. DOOR TO BE MODIFIED TO RECEIVE PANIC HARDWARE.</div></div>		<div><div></div><div>AREA NOT IN CONTRACT (N.I.C.)</div></div> <div><div></div><div>EXISTING WALL TO REMAIN.</div></div> <div><div>=====</div><div>EXISTING PARTITION TO BE DEMOLISHED AND REMOVED FROM SITE.</div></div> <div><div><div><div></div><div></div><div></div></div></div><div>EXISTING DOUBLE DOOR TO REMAIN. CLEAN AND REPAIR AS REQUIRED "LIKE NEW" CONDITION.</div></div> <div><div><div><div></div><div></div><div></div></div></div><div>EXISTING DOOR TO REMAIN. CLEAN AND REPAIR AS REQUIRED "LIKE NEW" CONDITION.</div></div> <div><div><div><div></div><div></div><div></div></div></div><div>EXISTING/NEW FRAMED GLASS STOREFRONT.</div></div> <div><div><div><div></div><div></div><div></div></div></div><div>EXISTING GLAZING TO BE DEMOLISHED AND REMOVED FROM SITE.</div></div> <div><div><div><div></div><div></div><div></div></div></div><div>EXISTING DOUBLE DOOR, FRAME AND HARDWARE IS TO BE REMOVED. RETURN TO BUILDING STORAGE PER BUILDING OWNER'S DIRECTION.</div></div> <div><div><div><div></div><div></div><div></div></div></div><div>REMOVE EXISTING OUTLETS AND PULL ALL WIRING BACK TO SUB-PANEL. PATCH/PREP WALLS AS REQUIRED FOR NEW FINISH.</div></div>	
					DEMOLITION KEYNOTES - SEPARATE PRICING		KEY PLAN			
					<div><div>B.1</div><div>REMOVE INTERIOR TENANT NON-LOAD BEARING WALLS AND ASSOCIATED ELECTRICAL, DATA, TELEPHONE AND J-BOXES. REMOVE ALL WIRING BACK TO ELECTRICAL SUB-PANELS.</div></div> <div><div>B.2</div><div>REMOVE ALL REMAINING FLOOR COVERING THROUGHOUT TENANT SPACE U.O.N. SCRAPE ALL FLOORS CLEAN OF ALL ADHESIVE, PAD, ETC. AND GRIND AS REQUIRED. TO SMOOTH FINISH AND BROOM CLEAN.</div></div> <div><div>B.3</div><div>REMOVE ALL REMAINING WALL FINISHES U.O.N. SKIM COAT AND PATCH TENANT WALLS AS REQUIRED TO PREPARE FOR APPROVED FINISH.</div></div> <div><div>B.4</div><div>GENERAL CONTRACTOR TO REMOVE EXISTING PLUMBING FIXTURES, RESTROOM PARTITIONS AND ACCESSORIES. ALL ITEMS TO BE DISCARDED.</div></div>		<div><div>SCOPE OF WORK</div><div></div></div> <div></div>			

PROJECT:
HIMALAYAN GRILL

SUITE 120
16400 PACIFIC COAST HWY
HUNTINGTON BEACH, CA 92649

saa
interiors + architecture
CULVER CITY, CA • IRVINE, CA • LOS ANGELES, CA
SAN FRANCISCO, CA • ISELIN, NJ • NEW YORK, NY
6083 Bristol Parkway
Culver City, CA 90030
18600 MacArthur Blvd., Suite 100
Irvine, CA 92612
515 South Flower St., Suite 1200
Los Angeles, CA 90071
535 Mission St., Suite 2027
San Francisco, CA 94105
485C US Route 1 South, Suite 105
Iselin, NJ 08830
711 3rd Ave., 6th Floor
New York, NY 10017
T 310.553.3252
T 949.724.8958
T 213.929.1400
T 415.390.6793
T 848.200.1200
T 917.512.6688
www.saaia.com

STAMP AND SIGNATURE:

CONSULTANTS:

DRAWINGS ISSUE		
DATE	DESCRIPTION	DELTA
11/07/19	ISSUE FOR ENGINEERING	
11/25/19	ISSUE FOR PLAN CHECK	
01/21/20	BULLETIN 1 - PLAN CHECK CORRECTIONS & TENANT REVISIONS	△
02/10/20	BULLETIN 2 - PLAN CHECK CORRECTIONS	△
05/07/21	REVISION TO PERMIT	△
06/11/21	PLAN CHECK CORRECTIONS	△

DATE:	10/31/19
DRAWN:	RW
REVIEWED:	MP
PROJECT NO:	626085.01
SCALE:	1/8" = 1'-0"
SHEET TITLE:	

DEMOLITION AND
DEMOLITION CEILING PLANS

SHEET NO:

A-1.0

FINISH PLAN

SCALE:
1/8"=1'-0"

2

CONSTRUCTION PLAN

SCALE:
1/8"=1'-0"

1

FINISH SCHEDULE

1	ITEM LOCATION MANUFACTURER COLOR FINISH INSTALLATION	PAINT REFER TO PLANS :TBS EGGSHELL AT DINING & HOSTING AREA, SEMI-GLOSS AT KITCHEN, BEVERAGE AND MOP SINK CLOSET :2 COATS PAINT
2	ITEM LOCATION MANUFACTURER COLOR FINISH INSTALLATION	ACCENT PAINT REFER TO PLANS :TBS :TBS :2 COATS PAINT
VP	ITEM LOCATION MANUFACTURER STYLE COLOR	:WALL PANEL KITCHEN WALLS :NUDO PEBBLED
PT	ITEM LOCATION MANUFACTURER STYLE COLOR SIZE BASE INSTALLATION GROUT NOTE	:PORCELAIN WALL TILE REFER TO PLANS :CROSSVILLE :FAMILIAR TERRITORY :FAMOD:TRAUPE UPS :12X24 :SK12 :PER MANUFACTURER SPECS; OFFSET 1/3 :TBS :WALL TILE TO EXTEND TO 6'-6" AFF.; PROVIDE ALUMINUM BAR STOCK AT EXPOSED EDGES.
PT	ITEM LOCATION MANUFACTURER STYLE COLOR SIZE BASE INSTALLATION GROUT	:PORCELAIN FLOOR TILE REFER TO PLANS :CROSSVILLE :FAMILIAR TERRITORY :FAMOD:CREME :12X24 :SK12 COVE BASE :PER MANUFACTURER SPECS; OFFSET 1/3 :TBS
LVT	ITEM LOCATION MANUFACTURER STYLE COLOR SIZE BASE INSTALLATION	:LUXURY VINYL TILE REFER TO PLANS :PATCRAFT :CROSSOVER 499V :AUSTIC 00770 :7"x48" :8-1/2" :PER MANUFACTURER SPECS
QT	ITEM LOCATION MANUFACTURER STYLE COLOR SIZE BASE INSTALLATION GROUT	:QUARRY TILE REFER TO PLANS :ARIZONA TILE :QUARRY TILE :COLORADO RED :6"x6" :6"x6" COVE BASE :PER MANUFACTURER SPECS :TBS
SC	ITEM LOCATION	:SEALED CONCRETE REFER TO PLANS
4	ITEM LOCATION MANUFACTURER STYLE COLOR SIZE INSTALLATION	:RUBBER WALL BASE REFER TO PLANS :JOHNSONITE :MANDALAY :TBS :4.5"; CONTINUOUS ROLLS :STRAIGHT AT CARPET, COVED AT HARD FLOORS
4	ITEM LOCATION MANUFACTURER STYLE COLOR SIZE GROUT	:SANITARY COVE BASE REFER TO PLANS :SALTILE :5-36197N :0100 WHITE :6"x6" :TBS

FINISH SCHEDULE

SB	ITEM LOCATION MANUFACTURER COLOR	SOLID SURFACE REFER TO PLANS :CASASSTONE :5641 OCEAN FOAM
PL	ITEM LOCATION MANUFACTURER COLOR FINISH	PLASTIC LAMINATE REFER TO PLANS :LAMINART :5308-T FLY ASH CONCRETE :TEXTURED


FINISH LEGEND

XX	WALL FINISH TYPE OF FINISH FINISH NUMBER
XX	SPECIAL FINISH TYPE OF FINISH FINISH NUMBER
XX	FLOOR BASE TYPE OF FINISH FINISH NUMBER
XX	FLOOR FINISH TYPE OF FINISH FINISH NUMBER
---	FLOOR TRANSITION
↔	PATTERN DIRECTION

DOOR SCHEDULE

DOOR TYPE	DOOR ELEVATIONS
A. BUILDING STANDARD SINGLE INTERIOR DOOR TYPE: BUILDING STANDARD FRAME: BUILDING STANDARD HEIGHT: FINISH: BUILDING STANDARD PAINT GRADE	200 201 300 ELEVATION A
DOOR HARDWARE LEVEL:	
1. INTERIOR LOCKSET LOCKSET: HINGES: DOOR STOP: CLOSER:	BUILDING STANDARD BUILDING STANDARD BUILDING STANDARD BUILDING STANDARD
2. INTERIOR RESTROOM PRIVACY LOCKSET LOCKSET: HINGES: DOOR STOP: CLOSER:	BUILDING STANDARD BUILDING STANDARD BUILDING STANDARD BUILDING STANDARD

DOOR DETAILS

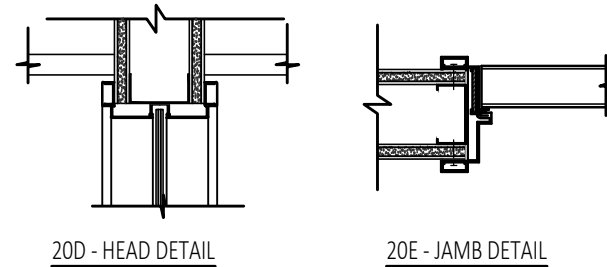

TYPICAL NOTES:
1. REFER TO SHEET A-2.0 FOR PARTITION TYPES.
2. REFER TO DOOR SCHEDULE FOR DOOR, FRAMES AND FINISHES.
3. ALL GLAZING THICKNESS TO BE PER PROVIDED DETAILS ON A-9.0, U.O.N.

CONSTRUCTION KEYNOTES

- 2.1 PROVIDE NEW PANIC HARDWARE AT EXISTING DOORS AS REQUIRED FOR EGRESS.
2.2 PROVIDE NEW 60 GALLON 180W WATER HEATER. TO BE INSTALLED ON STAND ABOVE SERVICE SINK. REFER TO PLUMBING DRAWINGS FOR MORE INFORMATION.
2.3 GC TO TIE INTO ADJACENT TENANT'S 2500 GALLON SHARED GREASE INTERCEPTOR. SEE KITCHEN AND PLUMBING DRAWINGS FOR MORE INFORMATION.
2.4 PROVIDE NEW STOREFRONT GLAZING AT EXISTING OPENING TO MATCH EXISTING.

NOTE:
CONTRACTOR TO IDENTIFY IN BID AND INCLUDE IN PRICING ALL ITEMS LIKELY TO BE REQUIRED BY TITLE 24, CHAPTER 6 PART 141.0 AND 141.1 BASED ON SCOPE OF WORK SHOWN IN PLAN. THIS SHALL INCLUDE (AS APPLICABLE) BUT NOT LIMITED TO: DISCREGATION OF ELECTRICAL PANELS, CONTROLLED RECEPTACLES, DANAIGHTING CONTROLS, OCCUPANCY SENSORS, MULTI-LEVEL SWITCHING AND/OR DIMMING, DEMAND RESPONSE AND HVAC EFFICIENCY MEASURES.


WALL TYPE

TYPE	DETAIL	DESCRIPTION
A	1/A-9.0	EXTEND TO FACE OF FINISHED CEILING. NO INSULATION. TYP. U.O.N.
B	6/A-9.0	EXTEND 6" PAST CEILING HEIGHT. PROVIDE INSULATION IN STUD CAVITY.
A	2/A-9.0	FULL HEIGHT WALL, ONE HOUR RATED. PROVIDE INSULATION IN THE STUD CAVITY. NOT USED.
A	2/A-9.0	FULL HEIGHT WALL. PROVIDE INSULATION IN THE STUD CAVITY.

CONSTRUCTION LEGEND

AREA NOT IN CONTRACT (N.I.C.).
EXISTING CONSTRUCTION TO REMAIN.
EXISTING/NEW FRAMED GLASS STOREFRONT.
NEW CONSTRUCTION, TYPICAL PARTITION UNLESS OTHERWISE NOTED.
EXISTING DOUBLE DOOR, DOOR FRAME AND DOOR HARDWARE IS TO REMAIN AT LOCATION SHOWN.
NEW SINGLE DOOR, DOOR FRAME AND HARDWARE.
PARTITION TYPE SYMBOL. SEE PARTITION TYPES LEGEND.
ROOM KEY SYMBOL. ROOM NAME ROOM NUMBER DOOR NUMBER
DOOR HARDWARE
DOOR TYPE
NOTE: ALL NEW DOOR PULL HARDWARE TO BE ACCESSIBLE, APPROVED "LEVER" TYPE. NOTE: ALL NEW DOORS ARE TO BE 3'-0" WIDE MIN. UNLESS OTHERWISE NOTED.
WALL MOUNTED FIRE EXTINGUISHER ON WALL HANGER BRACKET.
WALL MOUNTED WATER HEATER.

KEY PLAN

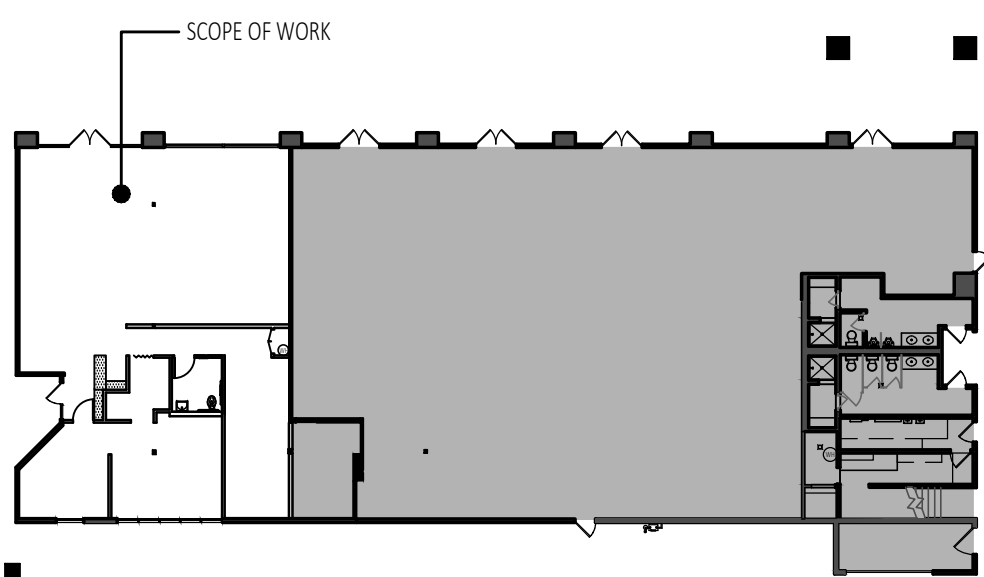

DRAWINGS ISSUE

DATE	DESCRIPTION	DELTA
11/07/19	ISSUE FOR ENGINEERING	
11/25/19	ISSUE FOR PLAN CHECK	
01/21/20	BULLETIN 1 - PLAN CHECK CORRECTIONS & TENANT REVISIONS	△
02/10/20	BULLETIN 2 - PLAN CHECK CORRECTIONS	△
05/07/21	REVISION TO PERMIT	△
06/11/21	PLAN CHECK CORRECTIONS	△

DATE:	10/31/19
DRAWN:	RW
REVIEWED:	MP
PROJECT NO.:	626085.01
SCALE:	AS NOTED
SHEET TITLE:	

CONSTRUCTION AND FINISH PLANS

SHEET NO.:

A-2.0

REFLECTED CEILING PLAN

SCALE:
1/8"=1'-0"

2

POWER/ VOICE/ DATA PLAN

SCALE:
1/8"=1'-0"

1

DESIGN CRITERIA NOTES

- FIRE AND LIFE SAFETY COMPONENTS**
1. ALL COMPONENTS SHALL BE WHITE U.O.N.
 2. FIRE PULL COMPONENTS SHALL BE RED OR OTHER OTHER ACCORDING TO LOCAL JURISDICTION.
 3. ALL STROBES SHALL BE CEILING MOUNTED, U.O.N. MOUNT IN CENTER OF ACOUSTIC CEILING TILES WHERE OCCURS, U.O.N.
 4. ALL SPRINKLER HEADS SHALL BE FULLY CONCEALED CEILING MOUNTED, U.O.N. MOUNT IN CENTER OF ACOUSTIC CEILING TILES WHERE OCCURS, U.O.N. WHERE BUILDING STANDARD IS SEMI-CONCEALED, HEADS AT GWB CEILINGS SHALL BE FULLY CONCEALED.
 5. COMPONENTS SHALL BE MOUNTED WITH CONSISTENT CENTERLINE, U.O.N.

- GENERAL**
1. ALL LINEAR DIFFUSERS SHALL BE FRAMELESS (MUD FLANGED) AT ALL GWB CEILINGS, U.O.N. GC SHALL SUPPLY AND INSTALL DIFFUSERS THE ENTIRE LENGTH AS SHOWN ON REFLECTED CEILING PLANS WHETHER AN ACTIVE OR INACTIVE SECTION. PAINT CEILING PLENUM AND ALL DUCT CONNECTIONS ABOVE FIXTURE MATTE BLACK U.O.N.
 2. PROVIDE AND INSTALL PERFORATED CEILING GRILLE PANELS AT ALL ACOUSTIC CEILING MOUNTED SUPPLY AND RETURN LOCATIONS, U.O.N. CONFIRM COLOR OF GRILLE WITH ARCHITECT BEFORE PURCHASE AND INSTALLATION.

REFLECTED CEILING KEYNOTES

- (4.1) PROVIDE EXHAUST FAN FOR NEW SINGLE USER RESTROOM. SEE MECHANICAL PLANS FOR MORE INFORMATION.
- (4.2) RENOV EXISTING MECHANICAL. REFER TO KITCHEN AND MECHANICAL DRAWINGS FOR MORE INFORMATION AS REQUIRED FOR KITCHEN EQUIPMENT.
- (4.3) PROVIDE DRYWALL ACCESS PANELS AND MUD-IN LINEAR DIFFUSERS AS REQUIRED AT NEW HAROLD CEILING. EXACT LOCATIONS TO BE COORDINATED W/ ARCHITECT.
- (4.4) CEILING SURFACES AT KITCHEN AREA MUST BE SMOOTH, NON-ABSORBANT, DURABLE AND WASHABLE.

REFLECTED CEILING LEGEND

- AREA NOT IN CONTRACT (N.I.C.)
- NEW 2nd CEILING SYSTEM
CEILING GRID
MANUFACTURER: ARMSTRONG
SIZE: PRELUDE 15/16" - HEAVY DUTY
SERIES: WHITE
COLOR: WHITE
CEILING TILE
MANUFACTURER: ARMSTRONG
SERIES: CLEAN ROOM VL
SIZE: 24X24X5/8"
COLOR: WHITE
REFERENCE SHEET A-9.0 FOR SPECIFICATIONS AND REQUIREMENTS.
- NEW DRYWALL CEILING, HEIGHT IS INDICATED IN BUBBLE. SEE DETAIL #15/A-9.0
- CEILING MOUNTED EXT SIGN. DARK QUADRANT INDICATES FACE, ARROW(S) INDICATE DIRECTION.
- CEILING HEIGHT AS INDICATED.

LIGHT FIXTURE SCHEDULE

MARK	SYMBOL	FIXTURE TYPE	MANUFACTURER	CATALOG NUMBER	COLOR TEMP.	LAMP	REMARKS
LF-1	⊗	DECORATIVE PENDANT FIXTURE	ACCORD	1217-F-26- STECCHE DI LEGNO 18 AMERICAN WALNUT	3000K	LED	TO COMPLY WITH TITLE 24 REQUIREMENTS GENERAL CONTRACTOR TO PROVIDE EXTRA CABLE LENGTH FOR ADJUSTMENT IN FIELD.
LF-2	⊕	DECORATIVE PENDANT FIXTURE	TECH LIGHTING	TECPBS228	3000K	LED	TO COMPLY WITH TITLE 24 REQUIREMENTS GENERAL CONTRACTOR TO PROVIDE EXTRA CABLE LENGTH FOR ADJUSTMENT IN FIELD.
LF-3	○	RECESSED 6" DOWNLIGHT	HALO COMMERCIAL	HCS200010-HM612890	3000K	LED	TO COMPLY WITH TITLE 24 REQUIREMENTS
LF-4	◻	DECORATIVE WALL SCONCE	PRIMA LIGHTING	913W-W2-L2-BK	TBS	LED	TO COMPLY WITH TITLE 24 REQUIREMENTS
LF-5	◻◻	CEILING MOUNTED WALL WASHER	WAC LIGHTING	MQ2020930WT	3000K	LED	TO COMPLY WITH TITLE 24 REQUIREMENTS
LF-6	◻	RECESSED 2X2 LED LIGHT	METALUX	22FP4235C	3500K	LED	TO COMPLY WITH TITLE 24 REQUIREMENTS
LF-7	---	LIGHTED MIRROR	PARIS MIRROR	GALAXY II	3000K	LED	TO COMPLY WITH TITLE 24 REQUIREMENTS
LF-X	⊙	EXIT SIGN	LITHONIA	EDG-G	-	LED	TO COMPLY WITH TITLE 24 REQUIREMENTS

ENLARGED REFLECTED CEILING PLAN

SCALE:
1/4"=1'-0"

3

POWER/ VOICE/ DATA KEYNOTES

- (3.1) PROVIDE POWER FOR NEW AUTOMATIC PAPER TOWEL DISPENSER. SEE A-0.7 FOR SPECIFICATION.
- (3.2) PROVIDE POWER FOR NEW AUTOMATIC FAUCET. SEE A-0.7 FOR SPECIFICATION.

DESIGN CRITERIA NOTES

- SWITCHES AND RECEPTACLES**
1. ALL SWITCHES AND RECEPTACLES AT P-1 AND/OR WHITE WALLS SHALL BE WHITE SCREWLESS, U.O.N. GC TO CONFIRM COLOR FINISH ON ALL SUCH COMPONENTS AT NON-WHITE WALLS WITH ARCHITECT BEFORE PURCHASE AND INSTALLATION.
 2. ALL RECEPTACLES INSIDE WHITE MILLWORK SHALL BE WHITE SCREWLESS, U.O.N.
 3. DEDICATED SWITCHES SHALL BE ORANGE OUTLET WITH WHITE OR SSTL PLATES.
 4. GC SHALL BE RESPONSIBLE FOR CONFIRMING RECEPTACLE TYPES FOR SPECIAL EQUIPMENT (SUCH AS COPY MACHINES) WITH CLIENT AND ARCHITECT BEFORE PURCHASE AND INSTALLATION.
 5. ALL VOICE AND DATA OUTLETS SHALL MATCH POWER OUTLETS AS ABOVE U.O.N.
 6. ALL DIMMER SWITCHES SHALL MATCH POWER SWITCHES AS ABOVE U.O.N.
 7. SWITCHES AND RECEPTACLES MAY BE LEVITON DECORA, LUTRON, OR COOPER, U.O.N.
 8. SUBMIT SAMPLES OF SWITCHES AND PLATES FOR APPROVAL.


ACCESSIBILITY NOTES

1. WHERE DINING SURFACES ARE PROVIDED FOR THE CONSUMPTION OF FOOD OR DRINK, AT LEAST 5% OF THE SEATING SPACES AND STANDING SPACES AT THE DINING SURFACE SHALL COMPLY WITH CBC 11B-902. IN ADDITION, WHERE WORK SURFACES ARE PROVIDED FOR USE BY OTHER THAN EMPLOYEES, AT LEAST 5% SHALL COMPLY WITH CBC 11B-902.
2. DINING SURFACES REQUIRED TO COMPLY WITH CBC 11B-902 SHALL BE DISPERSED THROUGHOUT THE SPACE OR FACILITY CONTAINING DINING SURFACES FOR EACH TYPE OF SEATING IN A FUNCTIONAL AREA. WORK SURFACES REQUIRED TO COMPLY WITH CBC 11B-902 SHALL BE DISPERSED THROUGHOUT THE SPACE OR FACILITY CONTAINING SURFACES. (11B-216.2)
3. THE TOPS OF DINING SURFACES AND WORK SURFACES SHALL BE 28 INCHES MINIMUM TO 34 INCHES MAXIMUM ABOVE FINISH FLOOR GROUND. (CBC 11B-902.4)

POWER/ VOICE/ DATA LEGEND

- WALL MOUNTED DUPLEX ELECTRICAL OUTLET. SEE ENGINEER'S DRAWINGS FOR CONDUIT SIZE.
- WALL MOUNTED QUADPLEX ELECTRICAL OUTLET. SEE ENGINEER'S DRAWINGS FOR CONDUIT SIZE.
- WALL MOUNTED GFI ELECTRICAL OUTLET, SEE INDIVIDUAL DEVICE TYPE. SEE ENGINEER'S DRAWINGS FOR CONDUIT SIZE.
- TELE COMMUNICATIONS/DATA WALL OUTLET. PROVIDE EMPTY J-BOX OR PLASTER RING & 3/4 DIA. EMPTY EXT CONDUIT STUBBED UP @ 4'-6" ABOVE SUSP. CLG. W/ PROTECTIVE PLASTIC RING & PULL STRING/ TENANT'S VENDOR TO PROVIDE COVER PLATES AND PLENUM RATED CABLES. VERIFY SIZE OF CONDUIT WITH CABLING/PHONE VENDOR OR WHEN FEEDING MORE THAN (1) LOCATION.
- N INDICATES NEW OUTLET.
- TYPICAL NOTE: WHERE PLUS HEIGHT IS INDICATED, HEIGHT IS NOT STANDARD. REFER TO TYPICAL SHEET NOTE A-0.1 FOR MOUNTING HEIGHT INFORMATION.

KEY PLAN

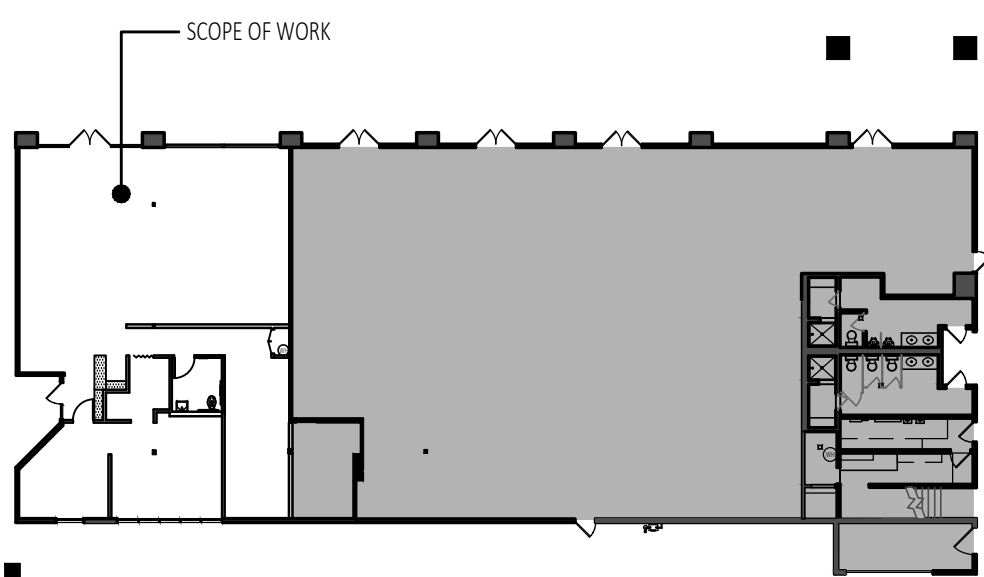

DRAWINGS ISSUE

DATE	DESCRIPTION	DELTA
11/07/19	ISSUE FOR ENGINEERING	
11/25/19	ISSUE FOR PLAN CHECK	
01/21/20	BULLETIN 1 - PLAN CHECK CORRECTIONS & TENANT REVISIONS	△
02/10/20	BULLETIN 2 - PLAN CHECK CORRECTIONS	△
05/07/21	REVISION TO PERMIT	△
06/11/21	PLAN CHECK CORRECTIONS	△

DATE:	10/31/19
DRAWN:	RW
REVIEWED:	MP
PROJECT NO:	626085.01
SCALE:	AS NOTED
SHEET TITLE:	

POWER VOICE DATA AND REFLECTED CEILING PLANS

SHEET NO:

			<div>1. SUBMITTALS: SEE GENERAL REQUIREMENTS SHEETS FOR SCHEDULE OF SUBMITTAL.</div> <div>2. W.I.C. STANDARDS: COMPLY WITH THE WOODWORK INSTITUTE OF CALIFORNIA "MANUAL OF MILLWORK", LATEST EDITION.<div>a) PROJECT STANDARD SHALL BE:<div><div>CUSTOM GRADE</div><div>PREMIUM GRADE</div></div></div><div>b) FLUSH OVERLAY CONSTRUCTION IS STANDARD, U.O.N.</div></div> <div>3. SCRIBE FINISH: SCRIBE ALL CASEWORK AND MILLWORK TO ADJACENT SURFACES, U.O.N.</div> <div>4. GROMMET HOLES: PROVIDE 3" DIAMETER WIRE/CORD MANAGEMENT HOLES AND PLASTIC GROMMETS WITH COVERS AT 40" ON CENTER AT ALL COUNTER TOPS. MILLWORKER'S SHOP DRAWINGS SHOW/INDICATE THE LOCATION, SIZE AND COLOR ON NEW GROMMETS. WHERE GROMMETS PENETRATE A BASE CABINET WITH ADJUSTABLE SHELVING, THE MILLWORKER SHALL PROVIDE A 3" PLASTIC LINED OPENING IN EACH SHELF. THE MILLWORKER WILL NEEDS TO VERIFY THE QUANTITY OF GROMMETS REQUIRED WITH THE DESIGNER DURING BIDDING. DESIGNER SHALL APPROVE GROMMET LOCATION WITH THE MILLWORK SHOP DRAWINGS.</div> <div>5. CABINET HARDWARE:<div>a) COMPLIANCE WITH STANDARDS: INSTALL FINISH HARDWARE COMPLYING WITH ANSI A156.9 "STANDARD FOR CABINET HARDWARE". SUBMITTAL: CABINET HARDWARE IS NOTED BY TYPE AND FINISH ONLY. SUBMIT LIST OF ALL ITEMS FOR APPROVAL PRIOR CONSTRUCTION.<div>PROPOSE HARDWARE TO DESIGNER FOR REVIEW AND APPROVAL PRIOR TO ORDERING.</div></div><div>b) PULL TYPE 1: DOUG MOCKETT DP3B</div><div>c) TYPICAL HINGES: CONCEALED CASEWORK HINGES, BLDG. STD. FINISH, FULL OVERLAY APPLICATION AND 110 DEGREES OPENING.</div><div>d) SHELVES STANDARDS: 3/4" MELAMINE SHELF WITH CHROME SHELF PINS IN 5MM HOLES AT 1-1/4" O.C.</div><div>e) DRAWER GLIDES: ACCURIDE FULL EXTENSION.</div><div>f) SILENCERS: PROVIDE SILENCERS AT ALL CABINET DOORS AND DRAWERS.</div></div> <div>6. ANCHORING AND BACKING: SECURE AND ANCHOR CASEWORK PER NOTES, DETAIL 11/- AND INDUSTRY STANDARDS. BACKING PROVIDED AND INSTALLED BY GENERAL CONTRACTOR.</div> <div>7. OPEN CABINETS: WHERE OPEN CABINETS ARE SHOWN, THE ENTIRE CABINET IS CONSIDERED TO BE EXPOSED SPECIFIED PLASTIC LAMINATE FINISH IS TO BE USED THROUGHOUT.</div> <div>8. CLOSED CABINETS INTERIOR FINISH IS TO BE WHITE "KORTON" INTERIOR SURFACES FOR CABINETS AND SHELVES, U.O.N..</div>	
--	--	--	---	--